
## T.35S.,R.4W.,W.M.

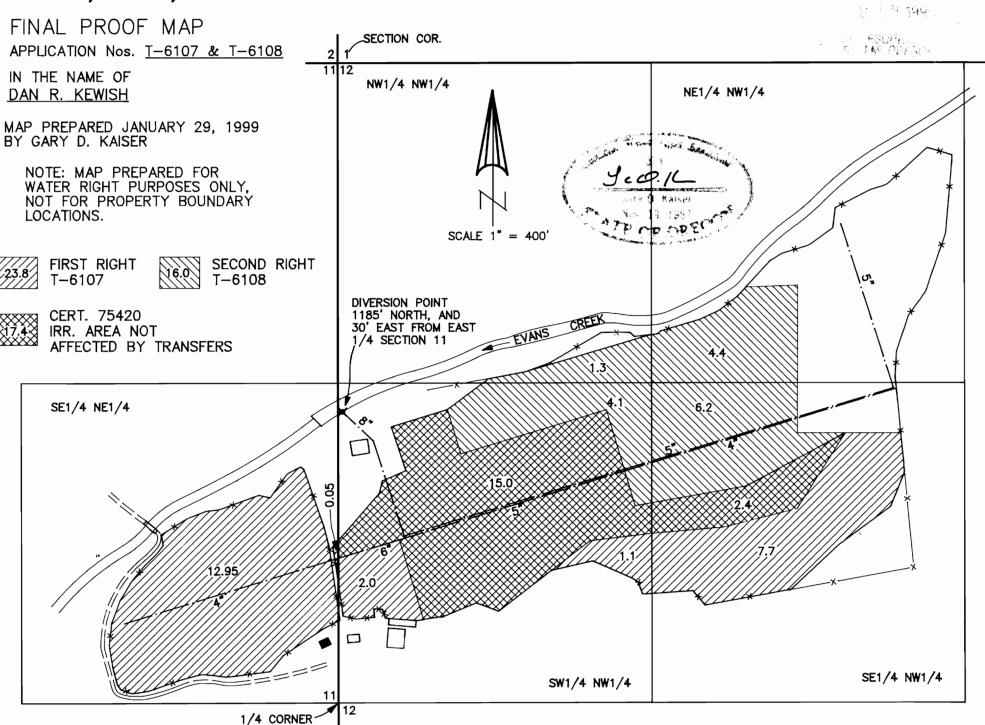

RECEIVED