


RECEIVED

WATER RESOURCES DEPT
DIVISION

T 13 S, R 33 E, W.M.

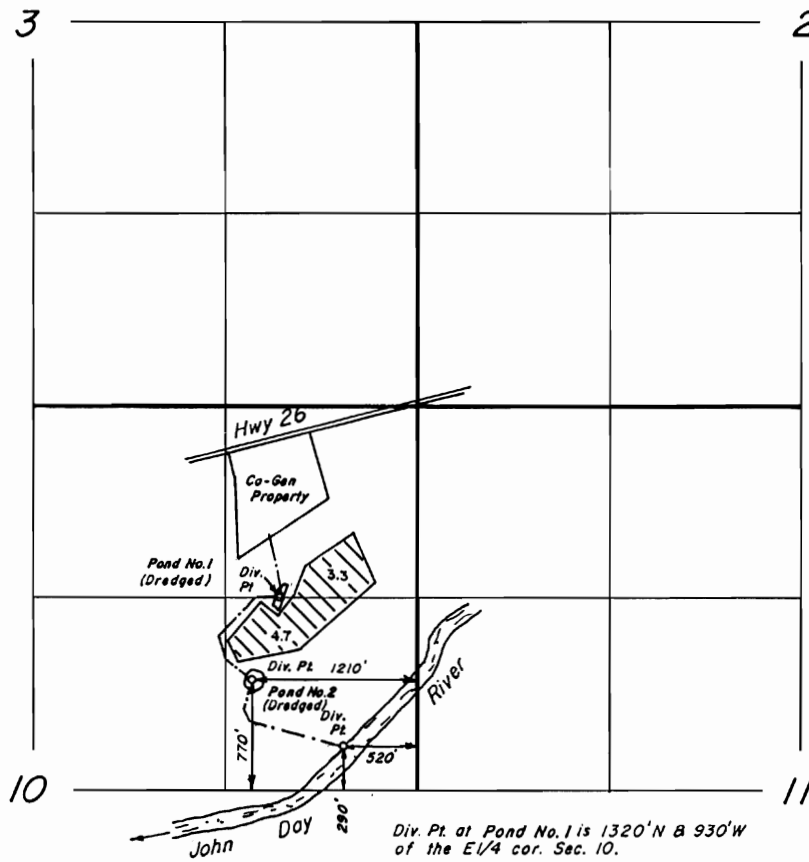

Scale 1" = 1320'

FINAL PROOF SURVEY

UNDER

Transfer No. 6113

Application No. G-11525 Permit No. G-10637

IN NAME OF

Co-Gen Co. & Prairie Wood Products
Don R. Johnson, General Manager

Surveyed Sept 28, 1989. By Robert D. Baggett
Revised July 30, 1992

