


T13S, R31E, W.M.

23 24
26 25

NW1/4NW1/4

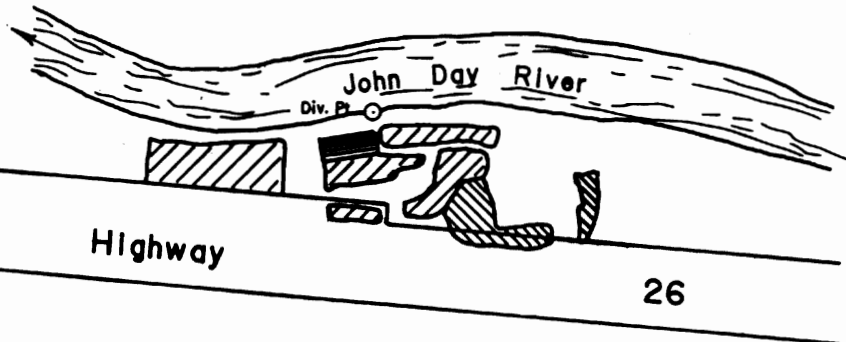

Scale 1" = 200'

Diversion point is 1900 ft. North and 4870 ft. West
of the E1/4 corner of section 25, T13S, R31E, W.M.



Greenhouse with potted plants
0.03 Acres



Outdoor potted plants
0.29 Acres



Lawn Irrigation
0.08 Acres



FINAL PROOF SURVEY

UNDER

Transfer No. 6129

IN NAME OF

Greg and Debra Eddy

NOTE:


The preparation of this map was for
the purpose of identifying the location
of the proposed water right and has
no intent to provide dimensions or
locations of property ownership lines.

Surveyed July 9, 1991 By *Robert D. Baggett*

Revised Aug. 27, 1991

Revised Feb. 2, 1996

T13S R31E W.M.

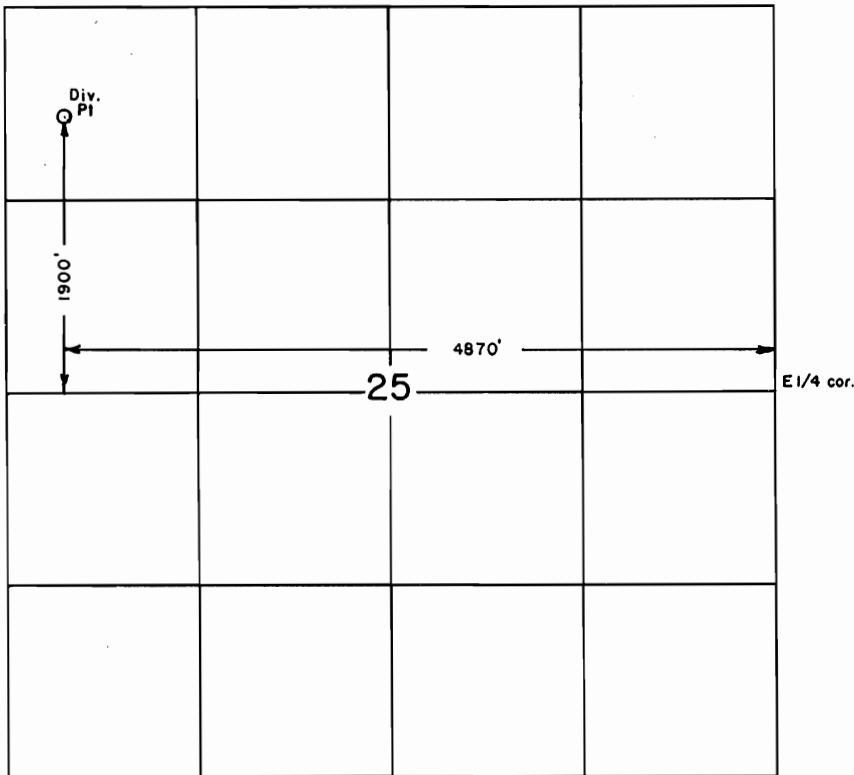

SCALE 1"=1320'


FINAL PROOF SURVEY

UNDER

Transfer No. 6129

IN NAME OF

Greg and Debra Eddy

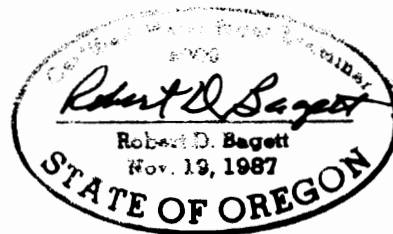

Surveyed July 9, 1991 By Robert D. Baggett
Revised May 14, 1992

NOTE: The preparation of this map was for the purpose of identifying the location of the proposed water right and has no intent to provide dimensions or location of property ownership lines.

SHEET 2 of 2