


T.11S., R.13E., W.M.
 NW 1/4 - NE 1/4 & NE 1/4 - NE 1/4
 SEC. 22


Claim of Beneficial Use map

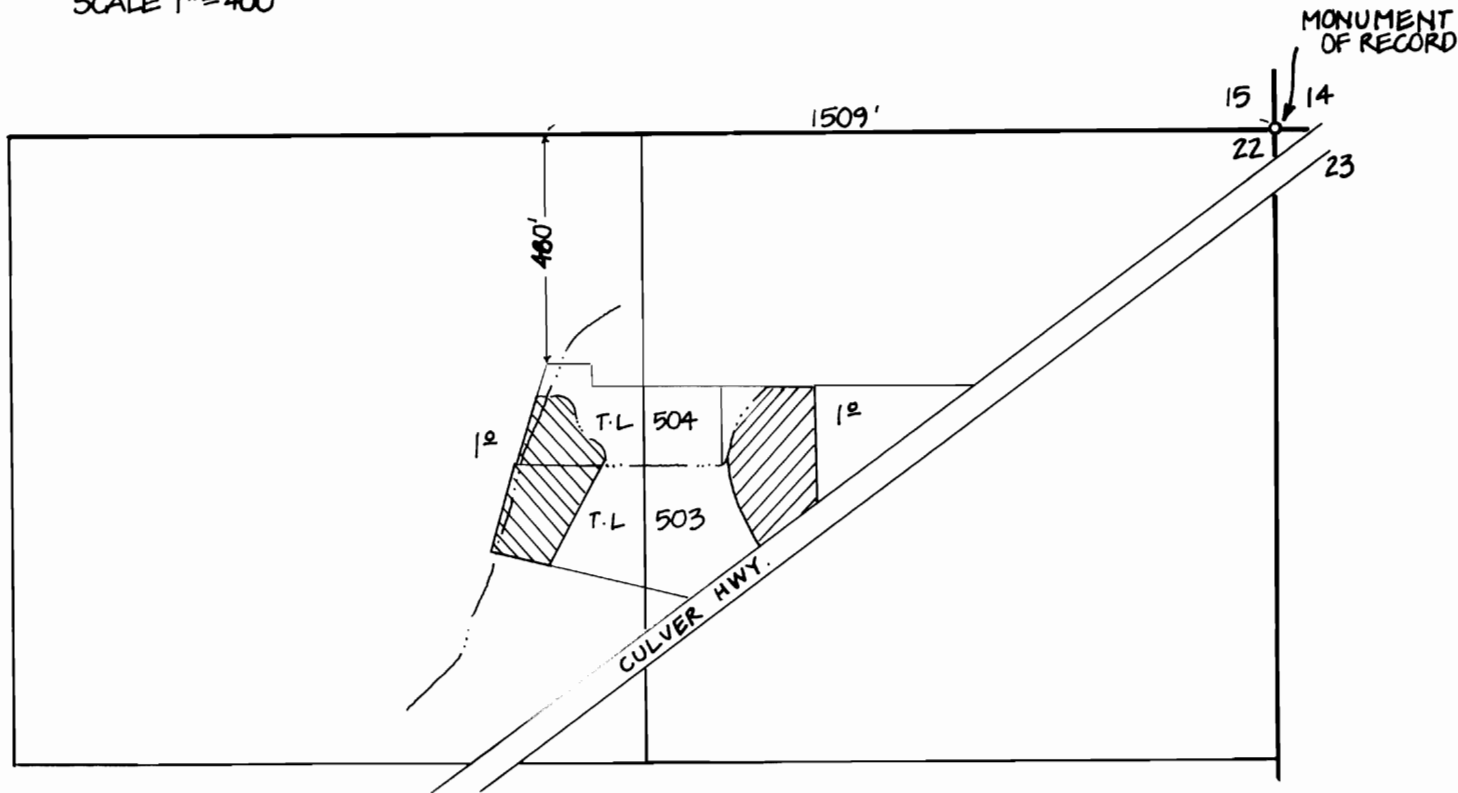

FINAL PROOF SURVEY
 UNDER

- | | | |
|---------------|---|--------|
| DESCHUTES |  | T-6136 |
| CROOKED RIVER |  | T-6136 |

IN THE NAME OF
 DENNIS H. & JANET L. WALLACE

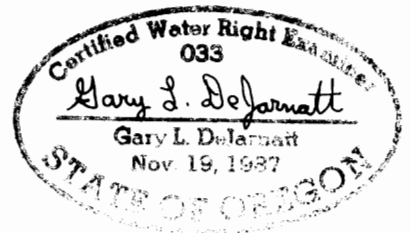

NO REPRESENTATION IS
 INTENDED TO PROVIDE
 DIMENSIONS OR LOCATION
 OF PROPERTY OWNERSHIP LINES.

PREPARED BY:
 DEJARNATT LAND SURVEYS, INC.
 63885 N. HWY. 97
 BEND, OREGON 97701

FIELD SURVEY: AUGUST 30, 1989

JOB # 88060 FP SEPT 8, 1989