


T13S R31E W.M.

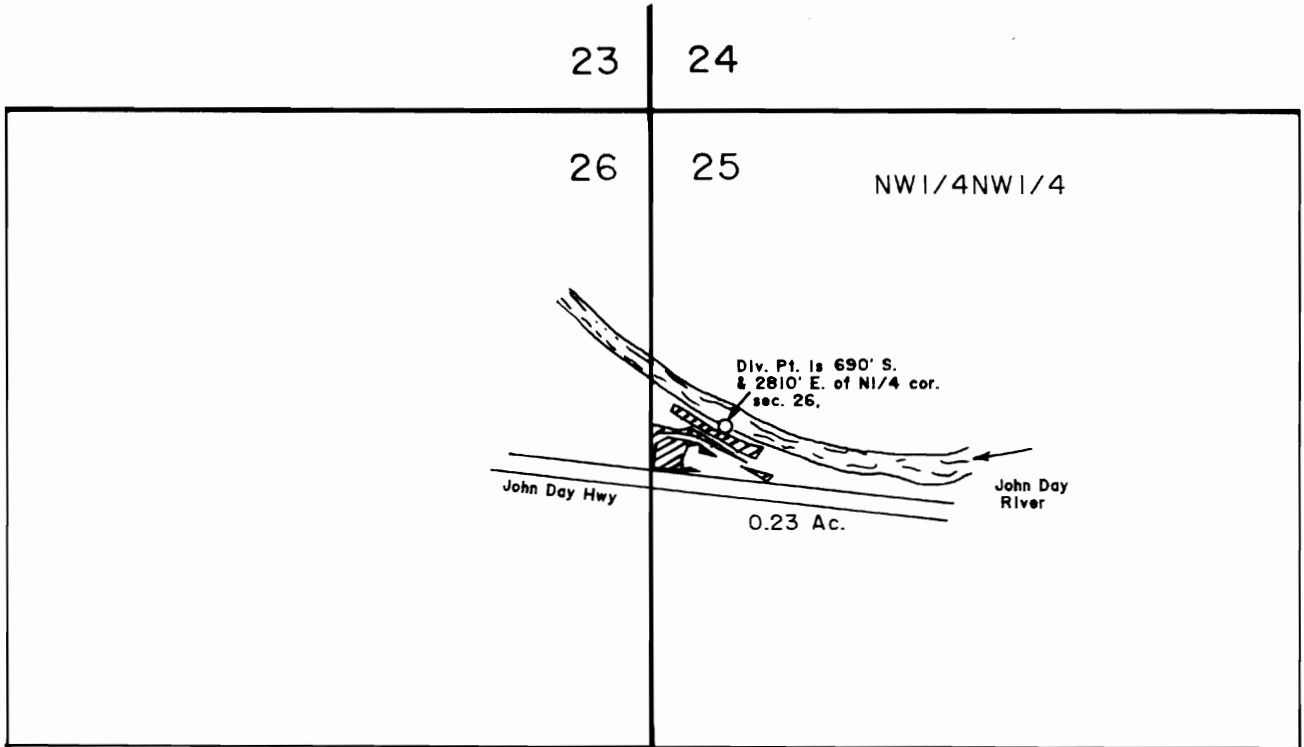

FINAL PROOF SURVEY
UNDER

TRANSFER NO. 6137

IN NAME OF

LISA F. ANDERSON AND FANNIE F. RUSSELL

SURVEYED SEPT, 26, 1990 BY *Robert D. Baggett*

