


T. 3 N., R. 29 E., W.M.

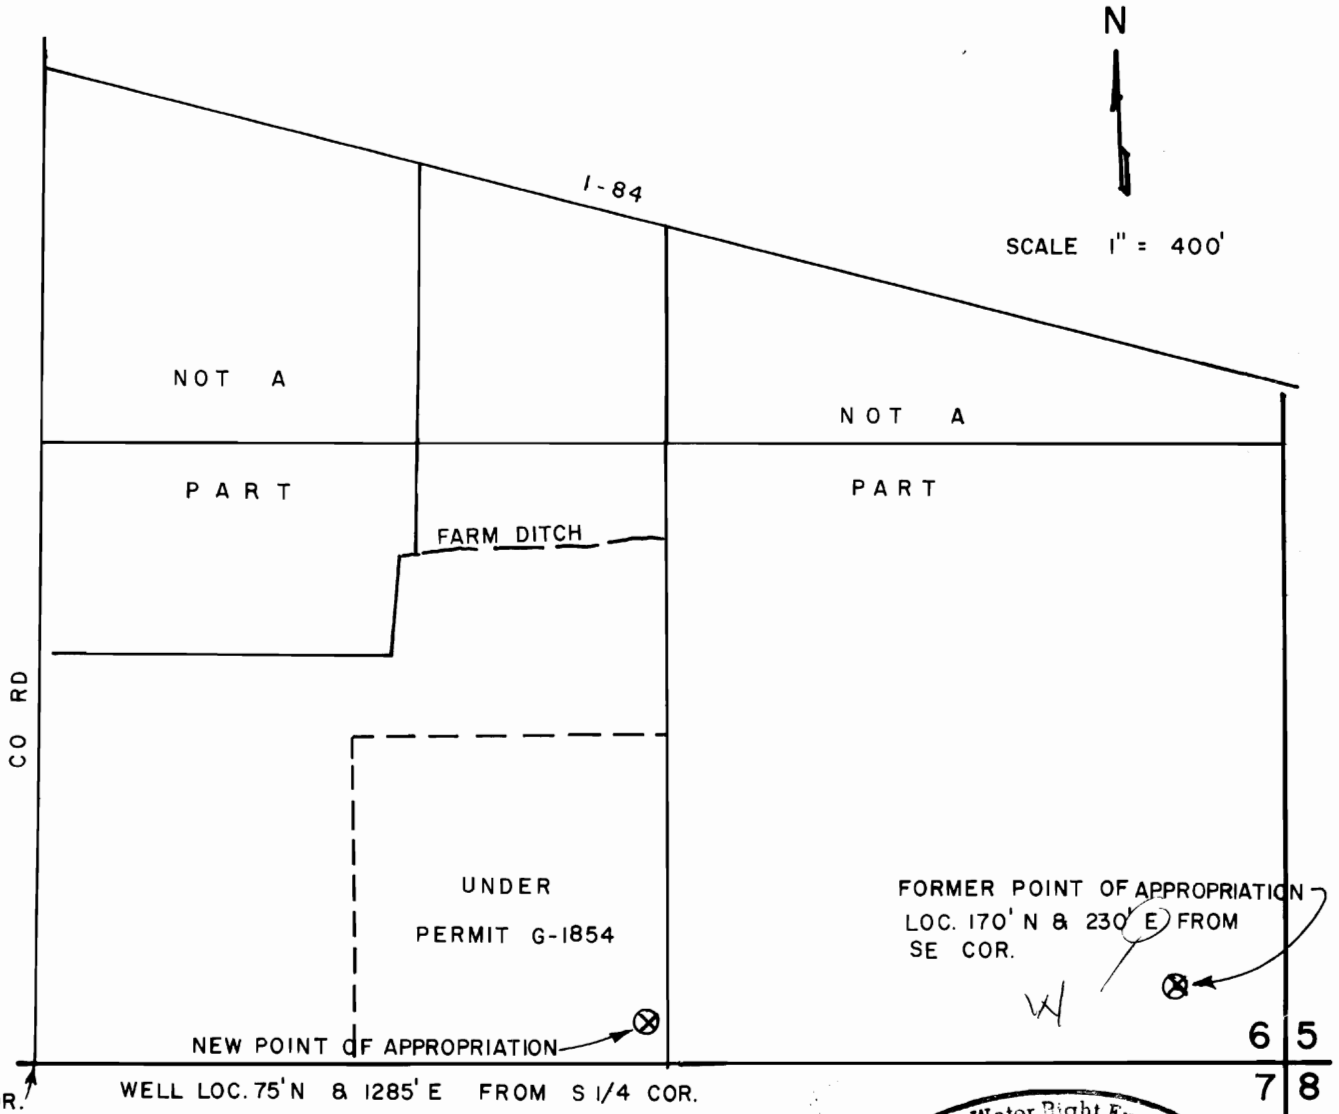

The preparation of this map was for the purpose of identifying the location of water right only, and has no intent to provide dimensions or locations of property ownership lines.



FINAL PROOF SURVEY

UNDER

Application No. T-6139 Permit No. G-1854 & G-4748

IN NAME OF

THE DEPARTMENT OF VETERANS' AFFAIRS

Surveyed JUNE 8, 1990, by W. N. REYNOLDS

REV. 9/13/91