


T30S R5W WM
SEC. 5

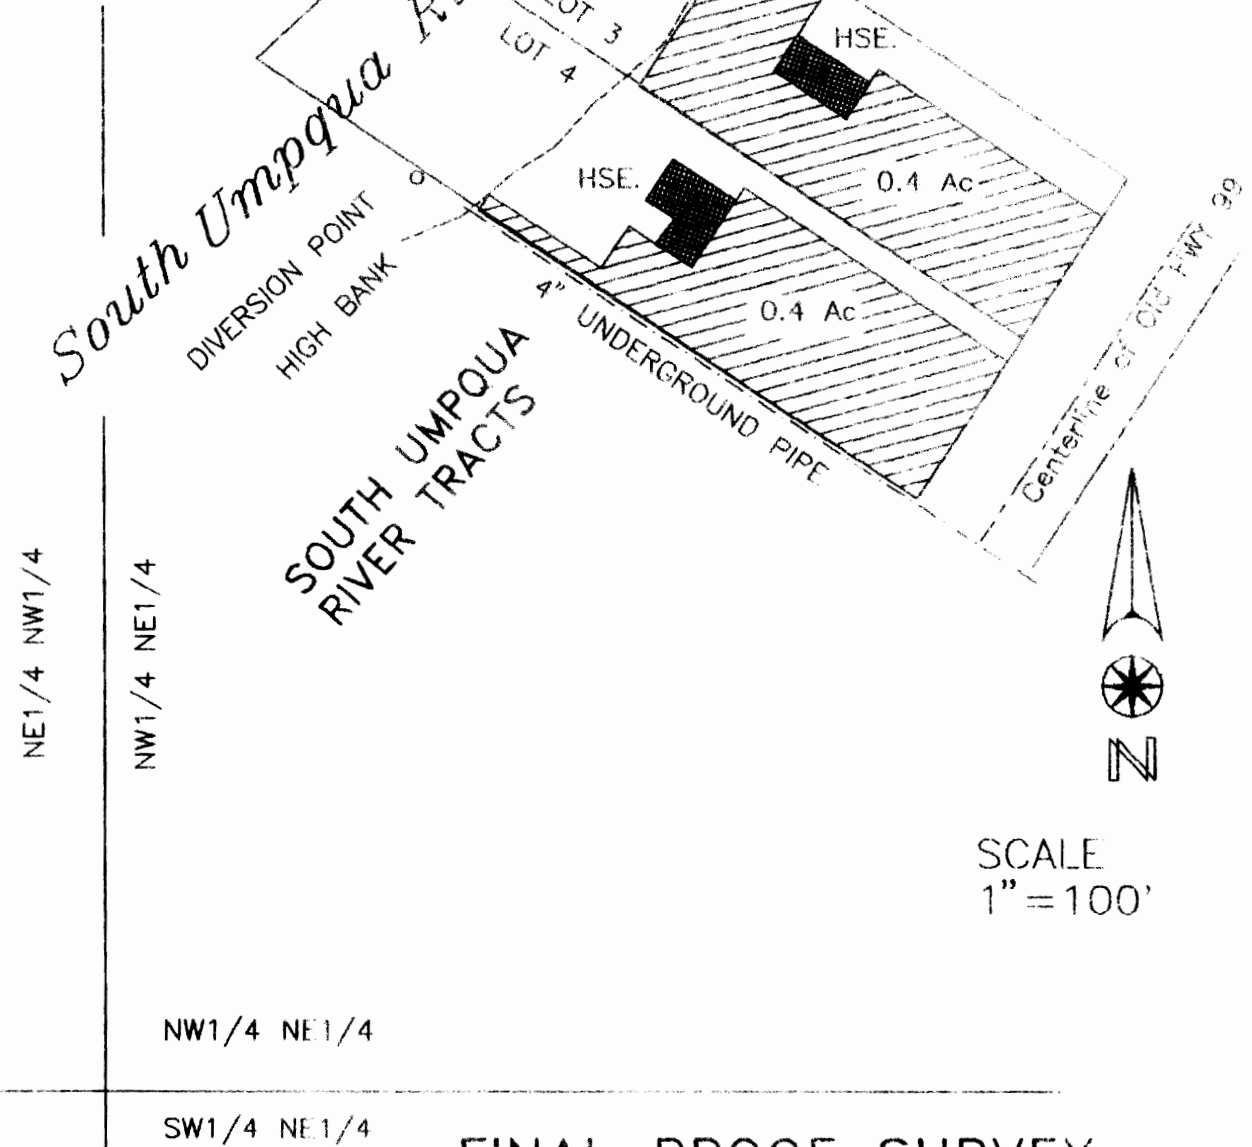

FINAL PROOF SURVEY

TRANSFER No.
T 6151

IN NAME OF
Ivan Pate

DATE SEPTEMBER 23, 1989

BY: WILLIAM J. RUPPERT
P.O. BOX 1564
MYRTLE CREEK, OR 97457