


T13S,R34E,W.M.

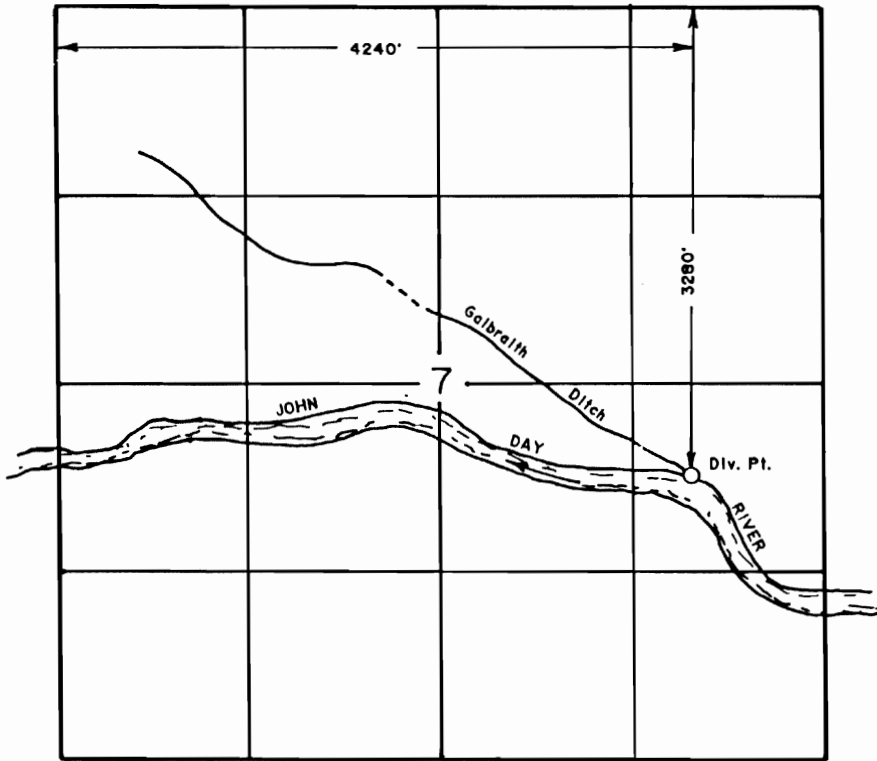


Scale 1"=1320'

RECEIVED

FINAL PROOF SURVEY
UNDER

WATER RESOURCES DEPT.
SALEM, OREGON

TRANSFER NO. 6164

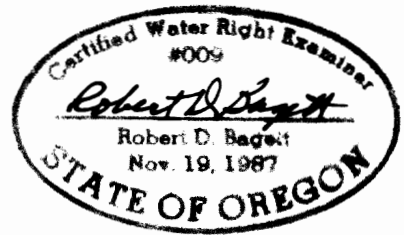

IN NAME OF

TIM LILLEBO & JOE DONALDSON

SURVEYED JULY 10, 1990 BY Robert D. Baggett