


T. 8 S., R. 39 E., W.M.
SECTION 26

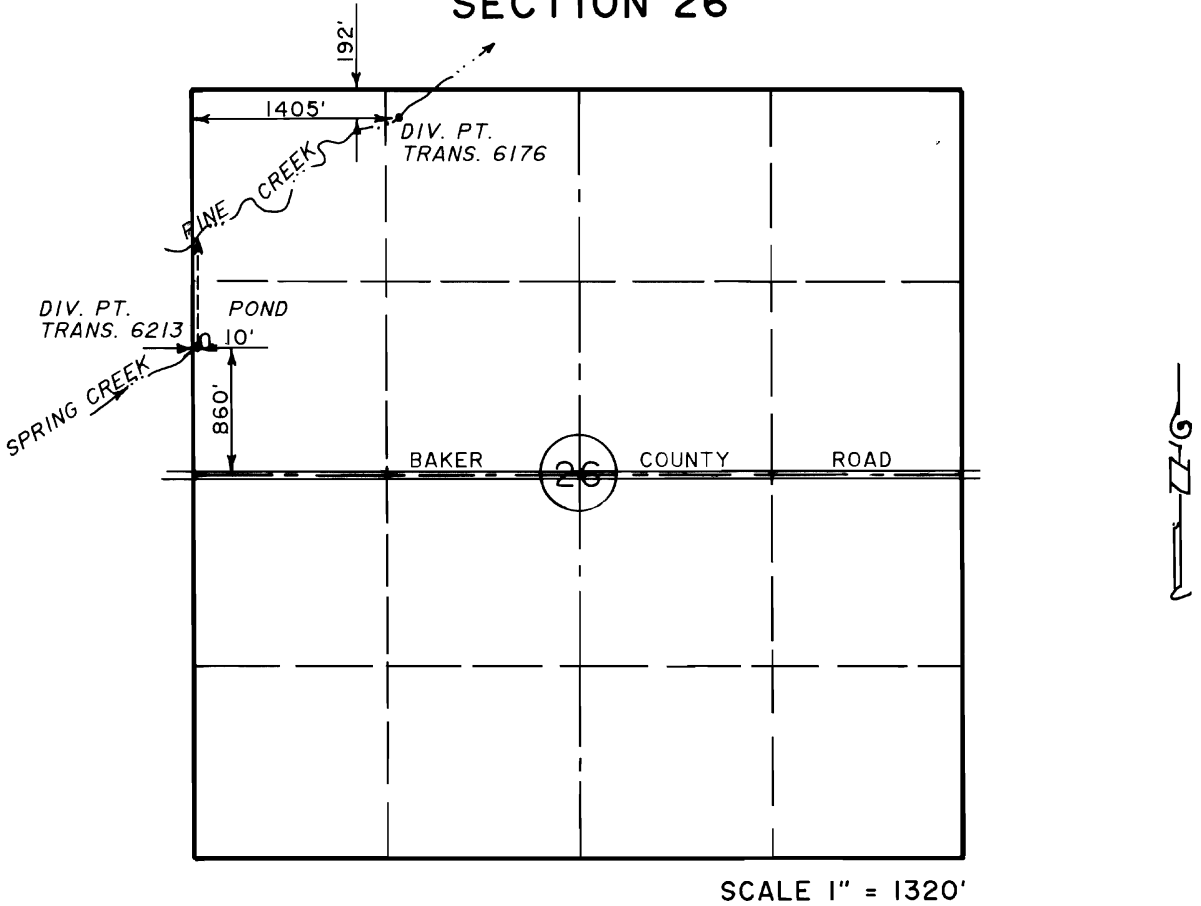

The purpose of this map is for identifying the location of the water right only and is not intended to provide legal dimensions of property ownership lines.

FINAL PROOF SURVEY

UNDER

TRANSFERS...6176 and 6213....

IN NAME OF

C. TOM & LYNNE D. HILL

Surveyed June 5, 1992 and May 5, 1993.

