


T.2N.R.4W.W.M.

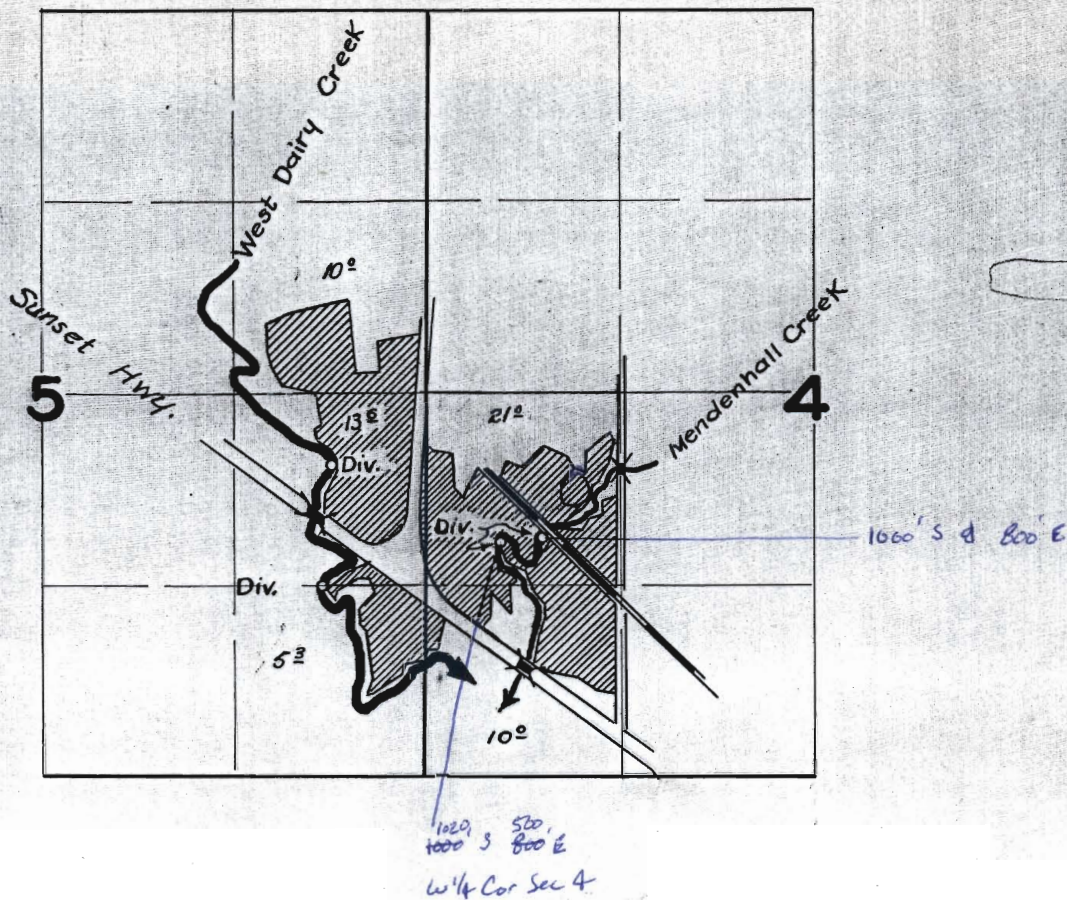

FINAL PROOF SURVEY UNDER

Application No. 16953 Permit No. 12697

IN NAME OF

H. E. McGRAW

Surveyed 7 / 2 1952, by H. L. COFFMAN