


SECTION 1 T. 25., R. 3W., W.M.  
WASHINGTON COUNTY, OREGON


1/4 COR



SCALE: 1" = 400'

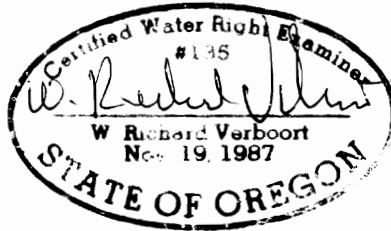

PREPARATION OF THIS MAP IS FOR THE PURPOSE OF IDENTIFYING THE LOCATION OF THE WATER RIGHT ONLY. THERE IS NO INTENT TO PROVIDE DIMENSIONS OR LOCATION OF PROPERTY OWNERSHIP LINES.

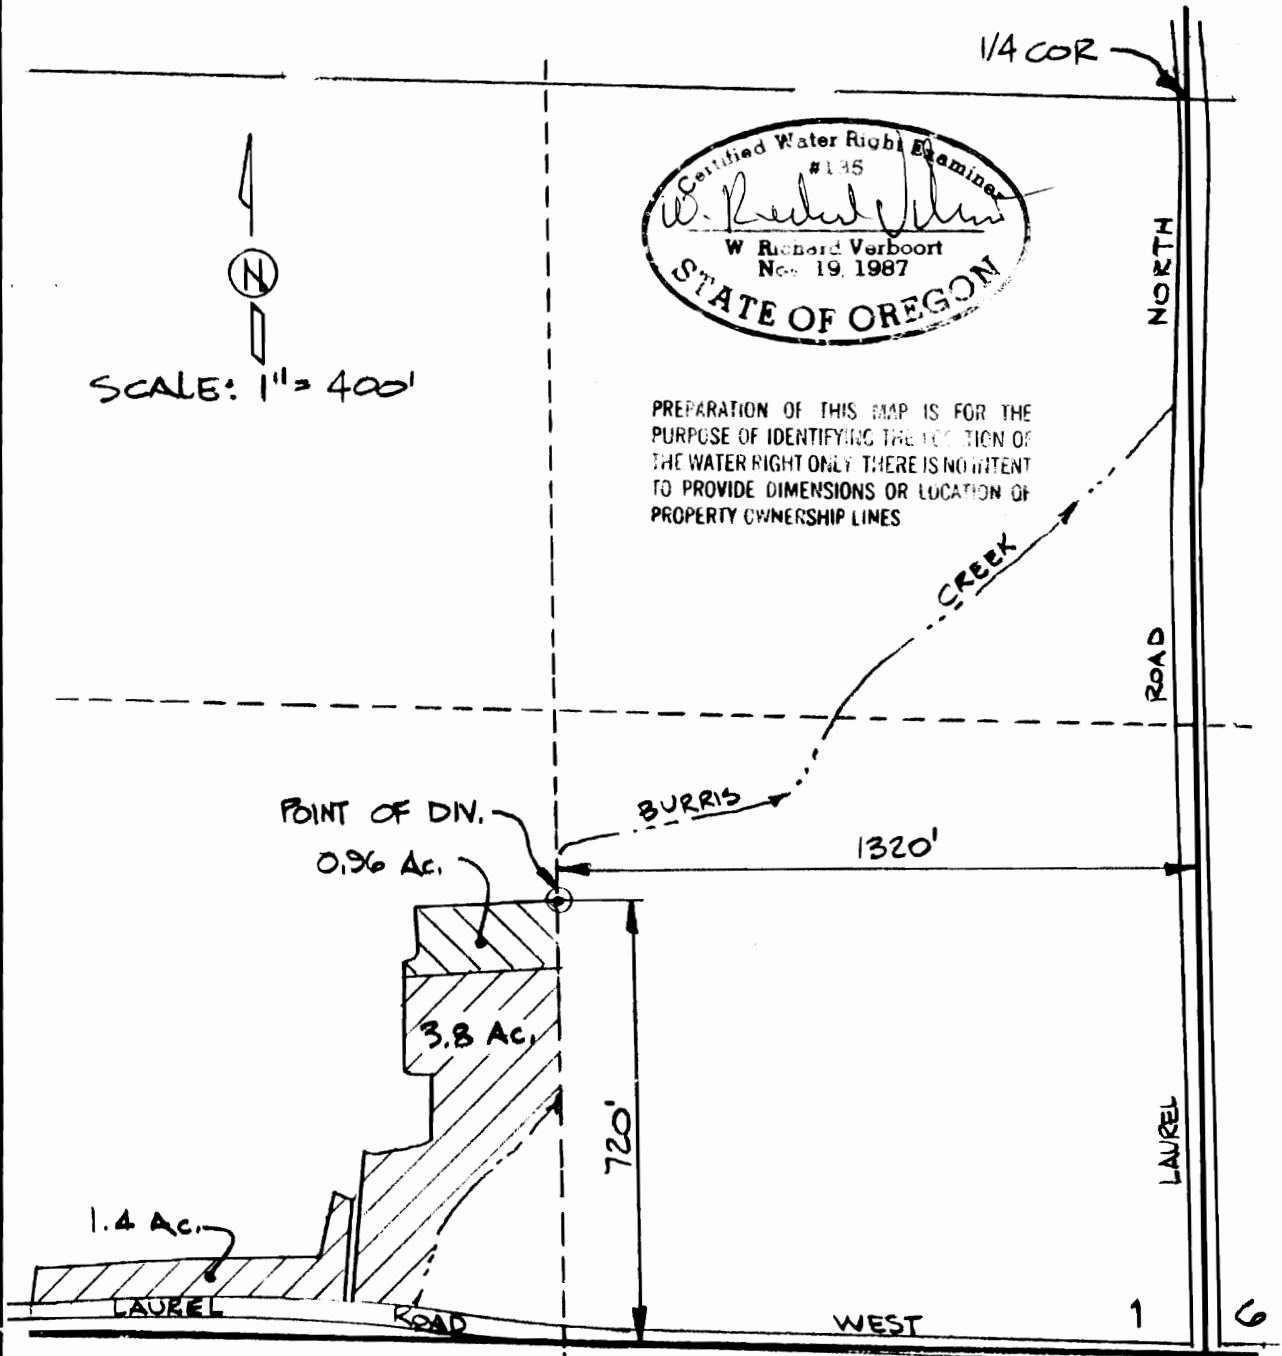

FINAL PROOF SURVEY

T-6191

SURVEYED JULY 28, 1992

VERBOORT ENGINEERING  
AGRICULTURE • CIVIL • WATER RESOURCES  
HILLSBORO, OREGON

by date  
designed WRV 8.92  
drawn JSE 8.92  
checked WRV 8.92  
drawing no. 92-A-09  
sheet no. 1/1

3/18/81 RICHARD EGGER  
3181 S. W. LAUREL RD.  
HILLSBORO, OR 97123