


T. 6 S., R. 38 E., W.M.

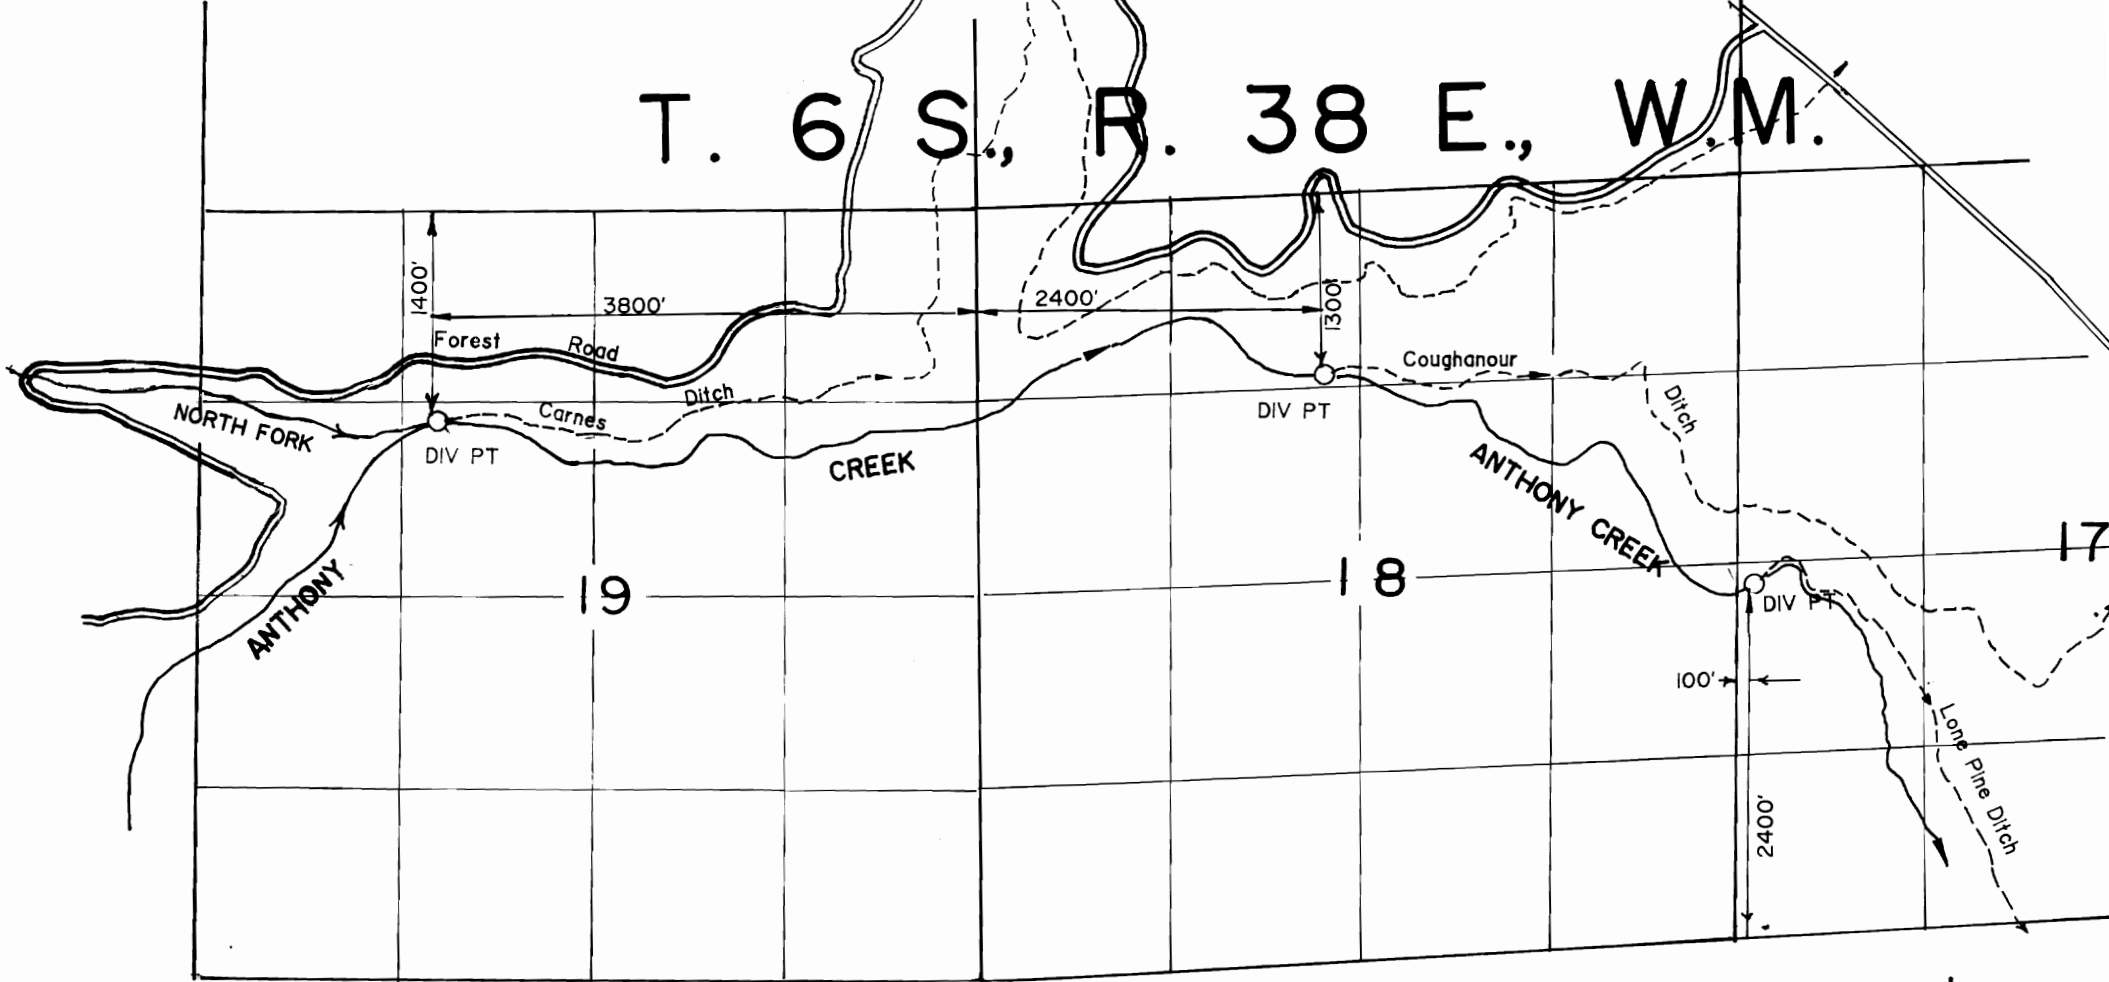

SCALE 1" = 1320'

The purpose of this map is for identifying the location of the water right only and is not intended to provide legal dimensions of property ownership lines.

FINAL PROOF SURVEY
UNDER

TRANSFERS 6218 AND 6219
IN NAME OF
POWDER VALLEY WATER CONTROL DISTRICT

Surveyed September 11, 12, 17, 1994



SUPERSEDED

