


DIV PT & RELEASE POINTS FROM PERMIT 50748

Applications 69635 E & 6085E
 PERMIT 50748

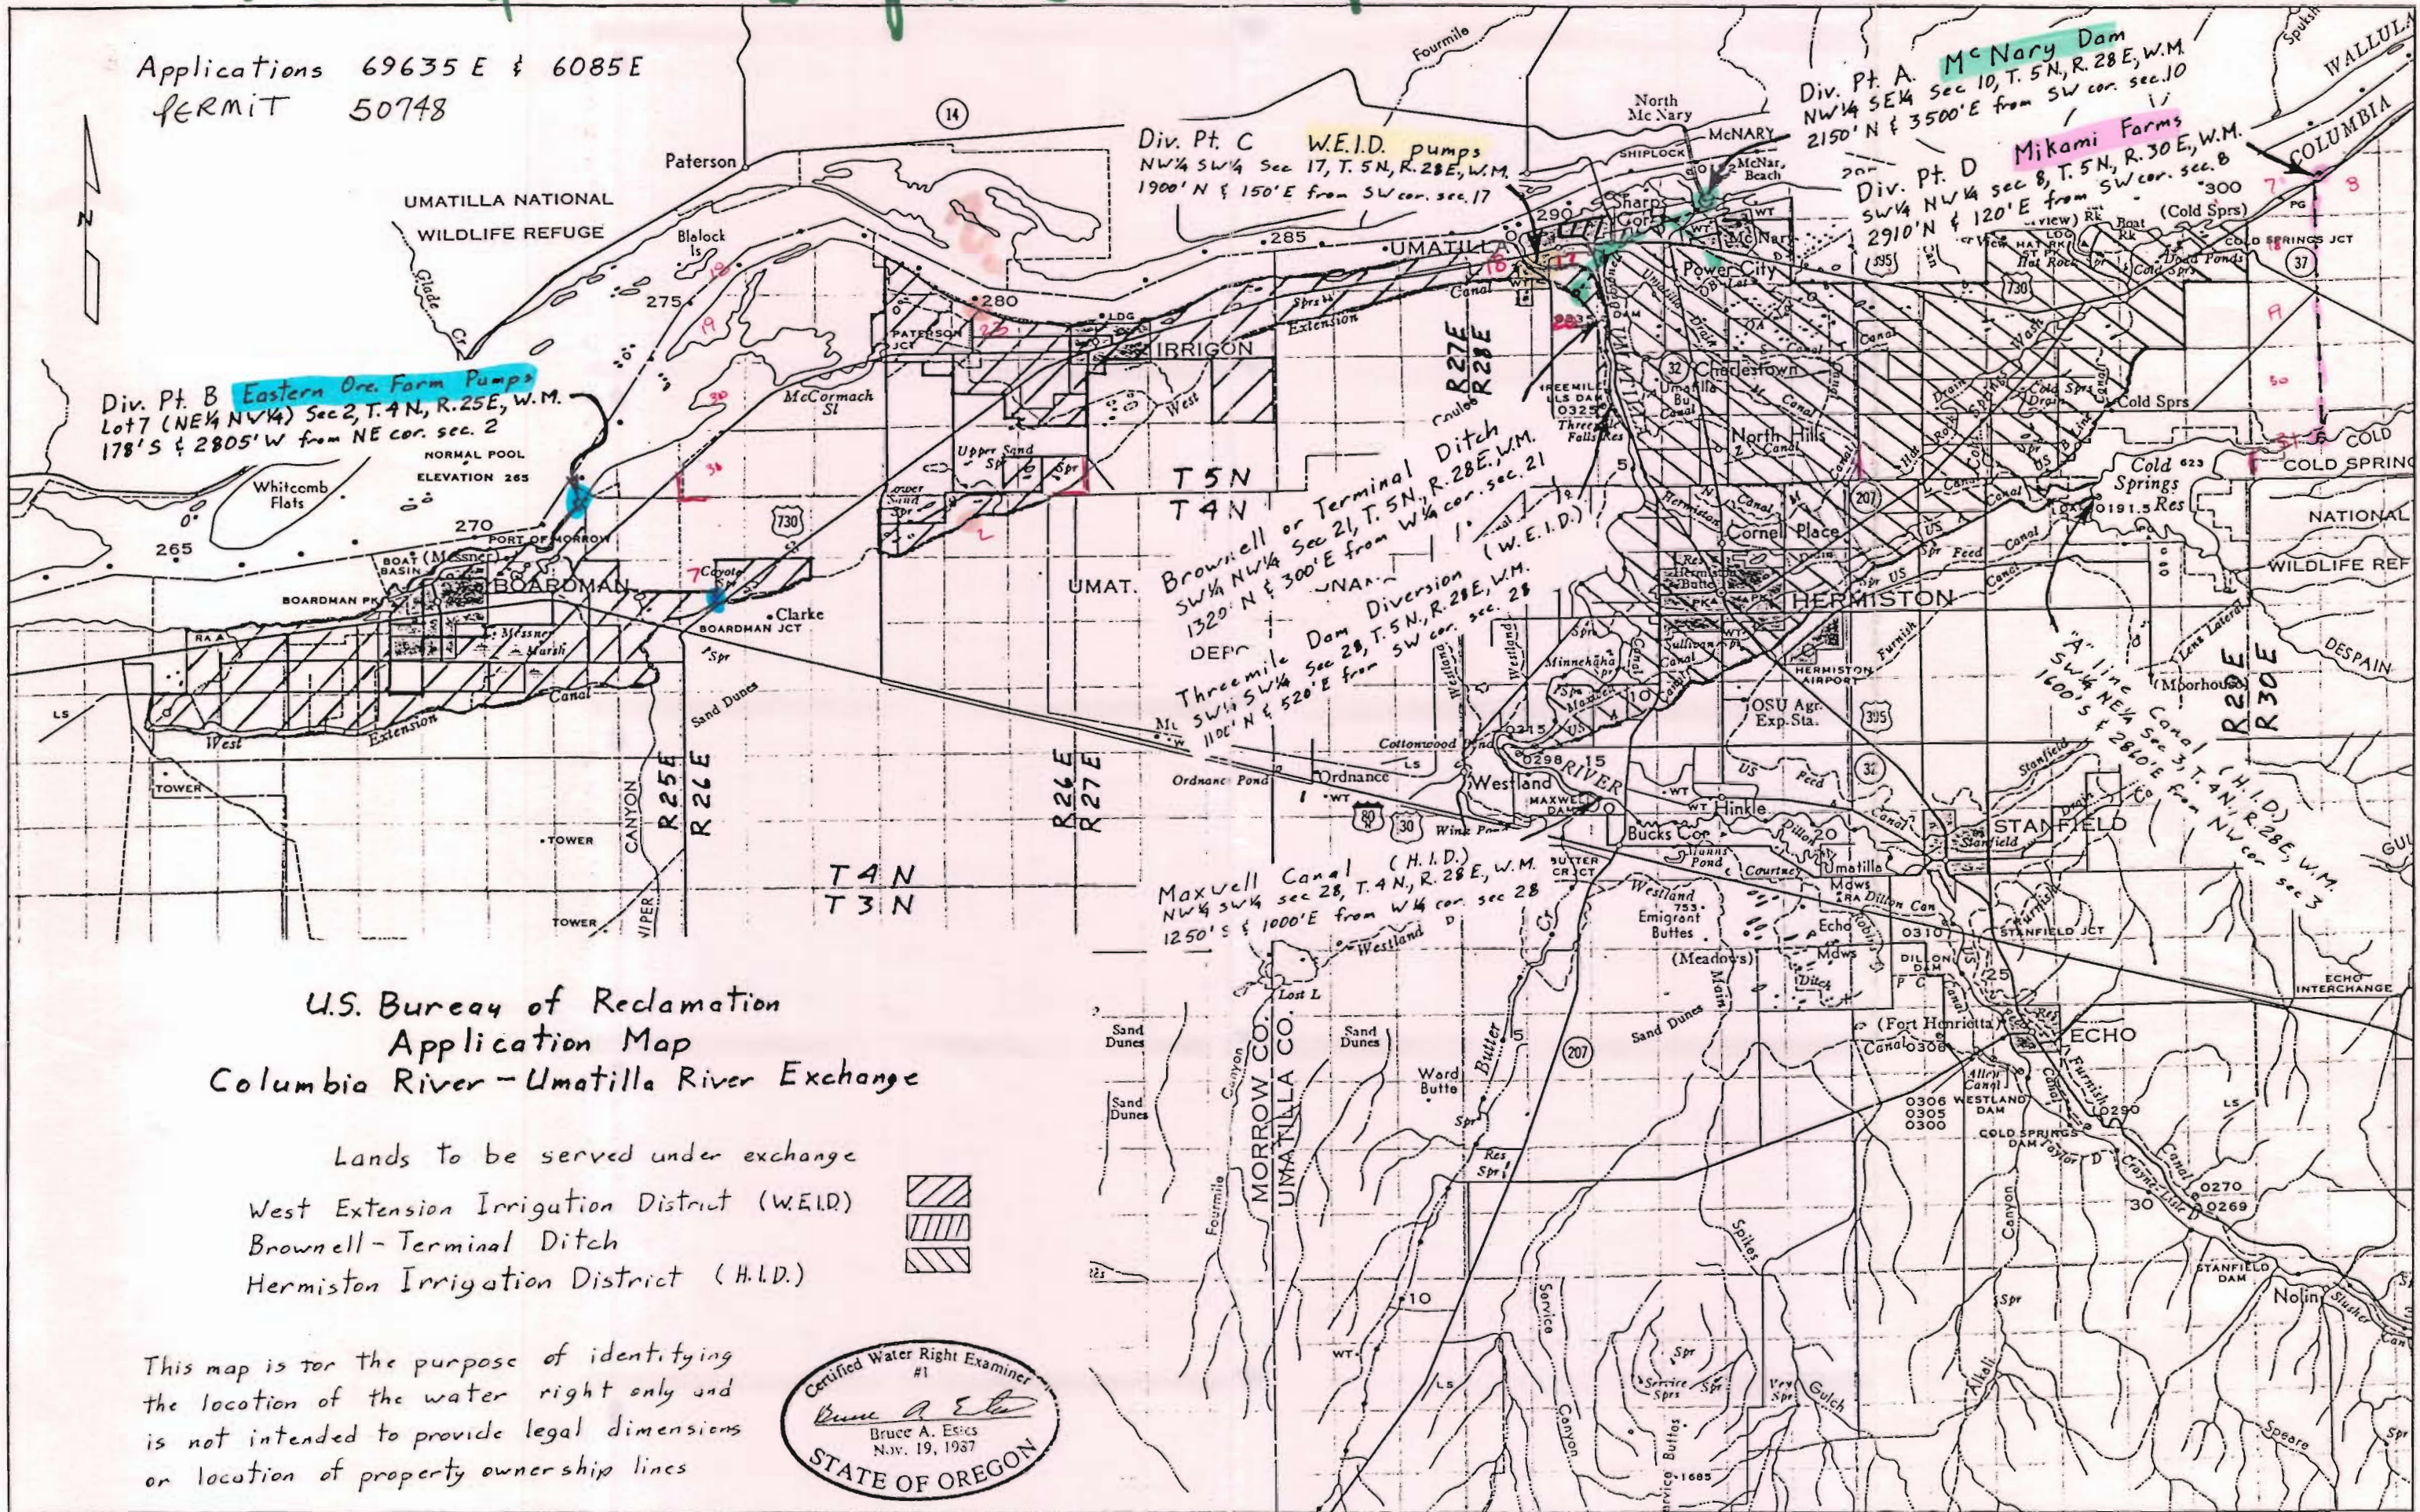

U.S. Bureau of Reclamation Application Map Columbia River - Umatilla River Exchange

Lands to be served under exchange

- West Extension Irrigation District (W.E.I.D.)
- Brownell-Terminal Ditch
- Hermiston Irrigation District (H.I.D.)

This map is for the purpose of identifying the location of the water right only and is not intended to provide legal dimensions or location of property ownership lines

