
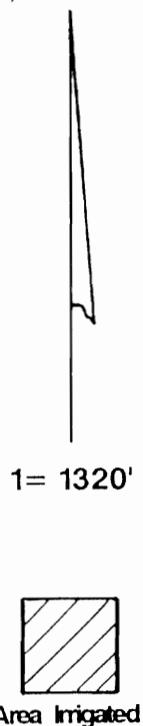


T.7S., R4W., W.M.

RECORDED
JUL 15 1994
BY 08201
COUNTY CLERK

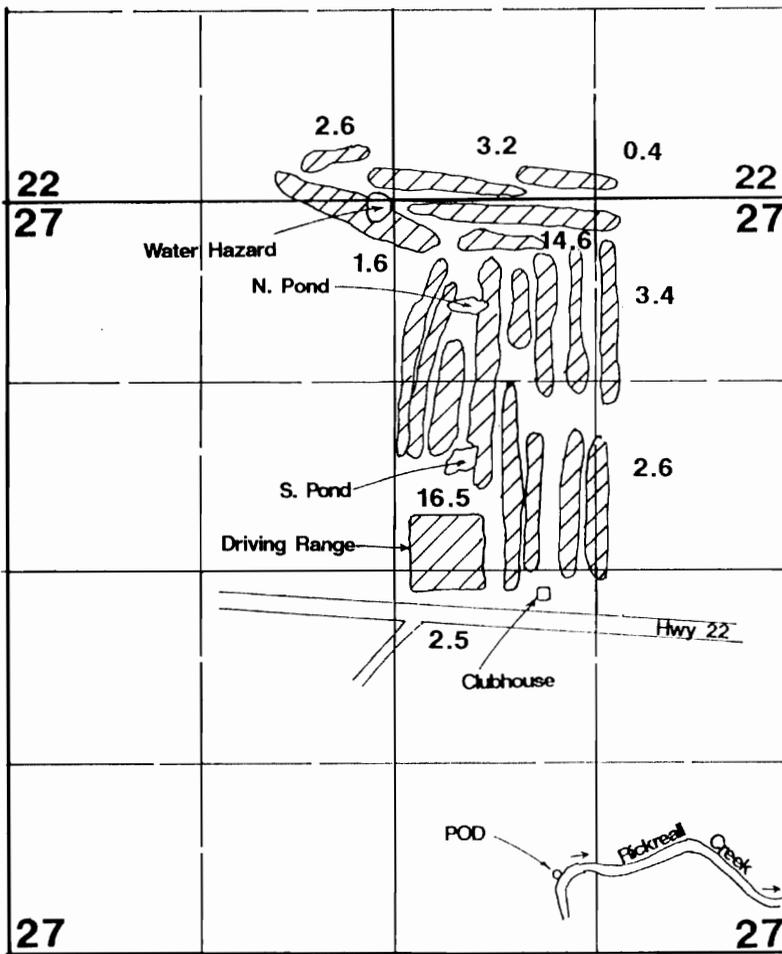

POD located 520'N & 1600'W from SE corner Section 27.

Final Proof Survey

Transfer #: T-6231

In Name Of

Oak Knoll Golf Course

Surveyed on August 24, 1993 by J Grimm
(Revised 7-15-94)

THIS MAP WAS PREPARED FOR THE PURPOSE OF IDENTIFYING THE LOCATION OF A WATER RIGHT ONLY AND IS NOT INTENDED TO PROVIDE LEGAL DIMENSIONS OR LOCATION OF PROPERTY OWNERSHIP LINES.