



T. 8 S., R. 39 E., W.M.

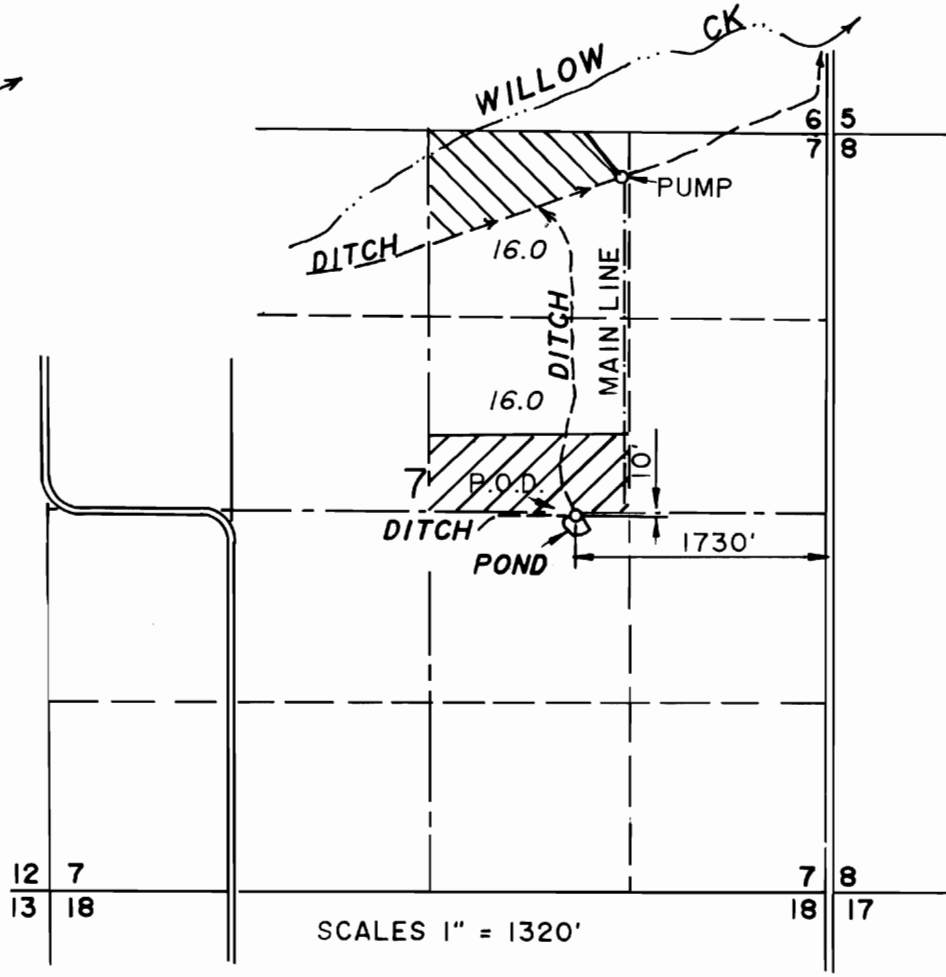

SCALE 1" = 1320'

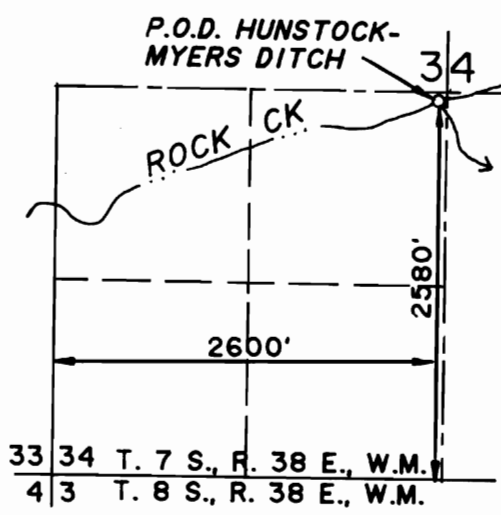

T-6573



T-6232

THE PURPOSE OF THIS MAP IS FOR IDENTIFYING THE LOCATION OF THE WATER RIGHT ONLY AND IS NOT INTENDED TO PROVIDE LEGAL DIMENSIONS OF PROPERTY OWNERSHIP LINES

FINAL PROOF SURVEY

UNDER

TRANSFERS 6232
6573

IN NAME OF

MARTHA JANE JACOBS

Surveyed JULY 28 1992

