


T.7S., R.38E., W.M.

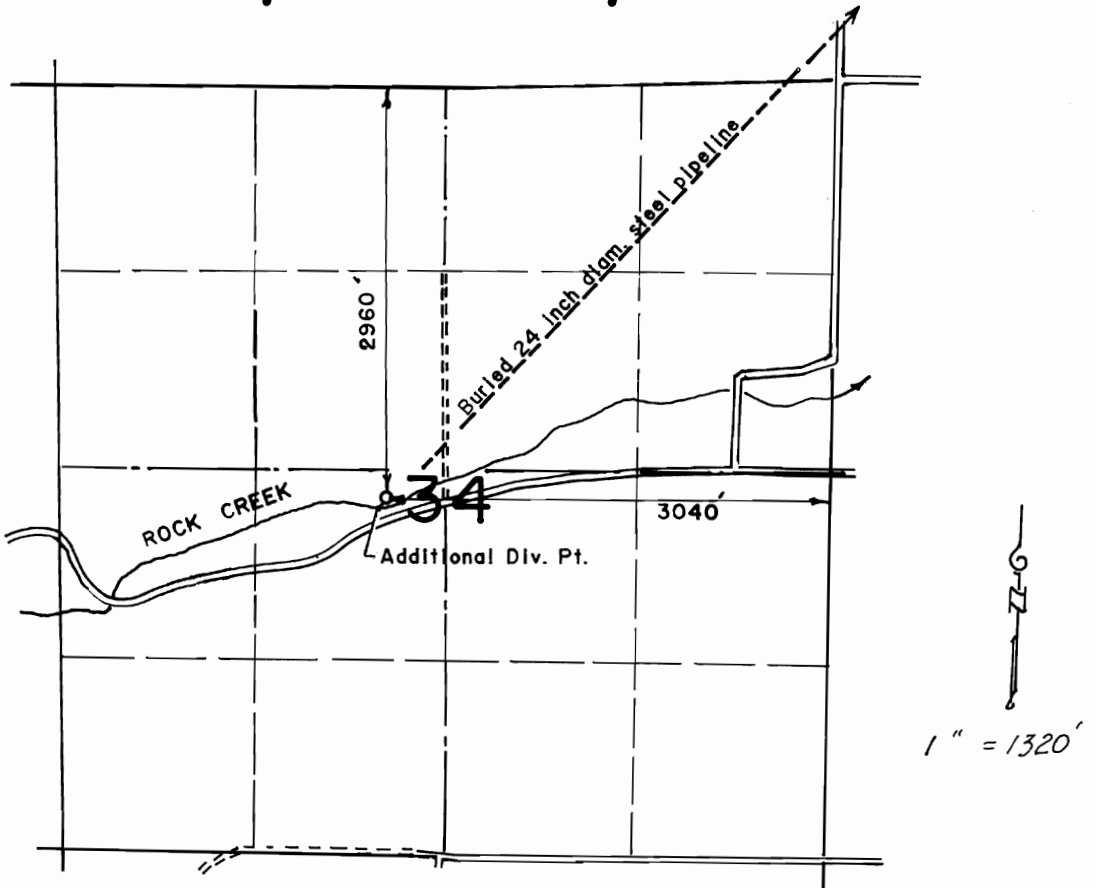

THE PURPOSE OF THIS MAP IS FOR IDENTIFYING THE LOCATION OF THE WATER RIGHT ONLY AND IS NOT INTENDED TO PROVIDE LEGAL DIMENSIONS OF PROPERTY OWNERSHP LINES.

**FINAL PROOF SURVEY**  
UNDER  
TRANSFERS 6074, 6234, 6284, 6285 and 6286  
IN NAME OF  
**POWDER VALLEY WATER CONTROL DISTRICT.**

Surveyed February 25, 1992.

