




T.16 S., R.12 E., W.M.

T.16 S., R.11 E., W.M.

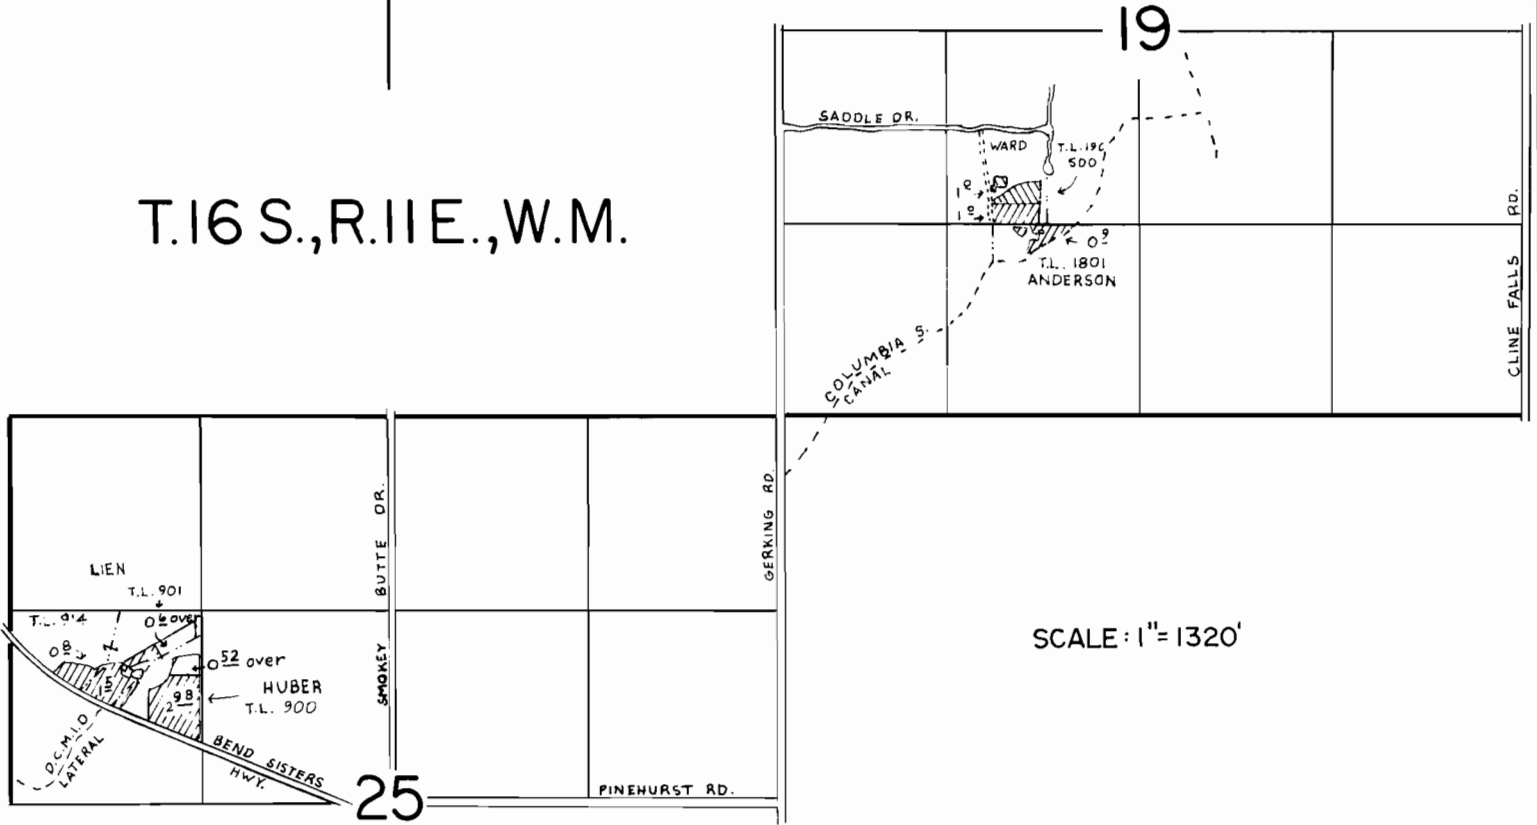

SCALE: 1" = 1320'

FINAL PROOF SURVEY
UNDER

TRANSFER NO.  2924 AND PART OF  4237 (1/6)

IN NAME OF
ANDERSON, HUBER, LIEN & WARD

Surveyed JUNE 16, 30 1986, by M. J. MATTICK.....