


RECEIVED

NOV 23 1992

WATER RESOURCES DEPT.
SALEM, OREGON

T.4S. R.1E. W.M.

CLACKAMAS COUNTY

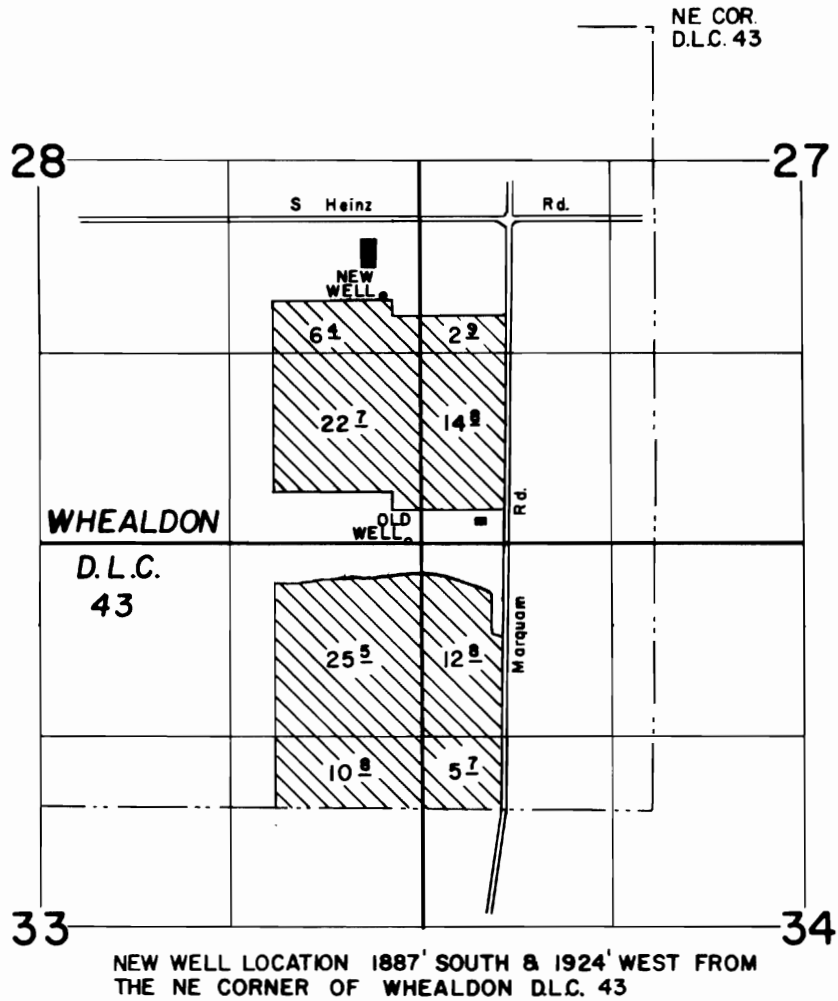

FINAL PROOF SURVEY

Application No G-2980 Permit No G-2776 Transfer No T-6262

YULE TREE FARMS

MAY 2, 1990
SCALE 1"=1320'



NOTE: This map is for the purpose of identifying the location of water rights and has no intent to dimension or locate property ownership lines.