

T. 2N & 3N., R. 26E., W.M.
 MORROW COUNTY
 SCALE 1" = 1320'

RECEIVED

MAR 28 1996

WATER RESOURCES DEPT
WATER RIGHTS PROOF MAP

IN NAME OF

**FINLEY BUTTES
 LANDFILL COMPANY**


T-6270, Permit #G-4918 & 37293
 T-6387, Permit #G-4281

THIS MAP IS FOR THE PURPOSE
 OF IDENTIFYING THE LOCATION
 OF WATER RIGHTS ONLY AND IS
 NOT INTENDED TO PROVIDE
 LEGAL DIMENSIONS OR LOCATIONS
 OF PROPERTY OWNERSHIP LINES.

Finley Buttes Landfill
 Company Use Area

T3N

T2N

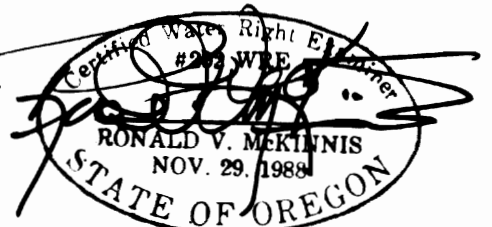

Exp. 12-31-96

Well 2340'
 1600'

Area Boundary —

Well Located 2340 Feet South and
 1600 Feet West of the NE Corner
 of Section 5, T. 2N., R. 26 E., W.M.
 SW 1/4 of NE 1/4

ENGINEERING - SURVEYING - WATER RIGHTS
R V MCKINNIS ENGINEERING
 Rt 1 Box 1122 Hermiston, Oregon 97838
 503-567-2017