


T. 36S., R. 3W., W.M.

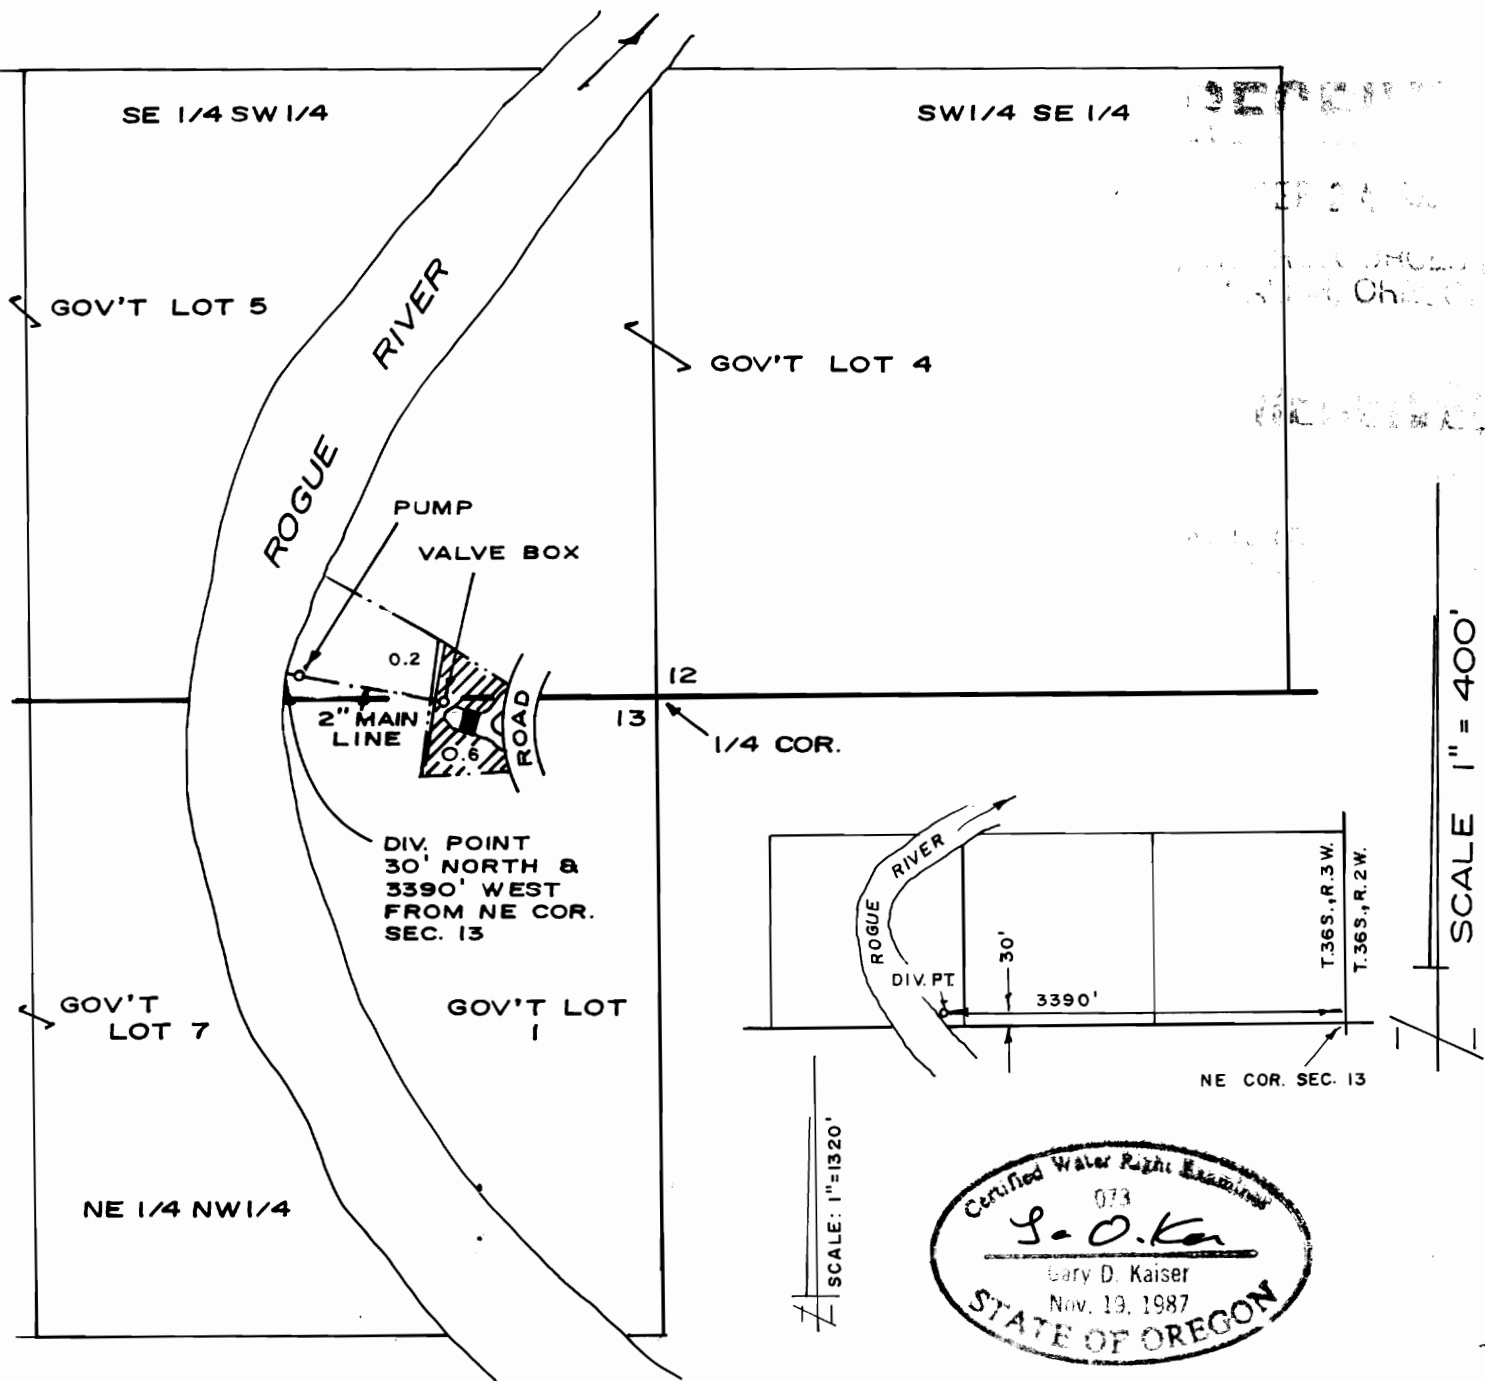

FINAL PROOF MAP

APPLICATION No. T-6301

IN THE NAME OF

DALE L. BOYLE

NOTE THIS MAP HAS BEEN
PREPARED FOR WATER RIGHT
PURPOSES ONLY, NOT FOR
PROPERTY BOUNDARY LOCATIONS

MAP PREPARED SEPTEMBER 18, 1991 BY GARY D. KAISER

REVISED MAY 4, 1992 G.D.K.

