
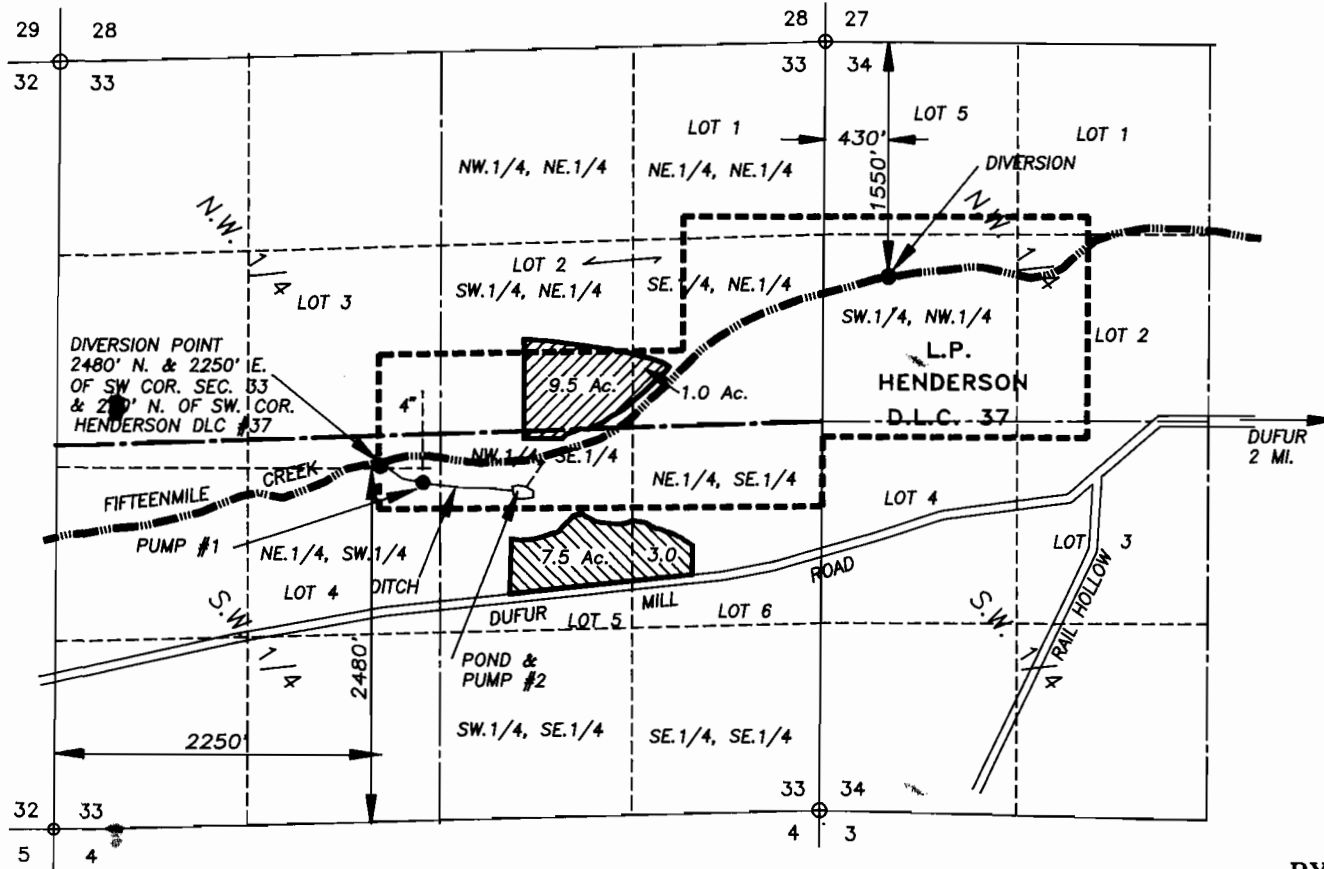


SECTION 33, TWP.1 S. RANGE 13 E. W.M. WASCO COUNTY, OREGON

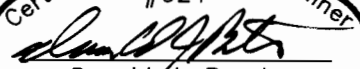

APPLICATION No. T-6277  
 PERMIT No. 44313 (1977)  
 AND  
 CERTIFICATE No. 49488 (1856)  
 IN THE NAME OF:  
GENE UNDERHILL  
 DATE: SEPTEMBER 9, 1992

 TRANSFERRED 1977 TO  
 TRANSFERRED 1856 FROM  
 TRANSFERRED 1856 TO  
 TRANSFERRED 1977 FROM

Certified Water Right Examiner  
 #024  
  
 Donald J. Branton  
 Nov. 19, 1987  
 STATE OF OREGON  
 Renew 12/31/99

BY: TENNESON ENGINEERING CORP.  
 409 LINCOLN STREET,  
 THE DALLES, OREGON. 97058  
 PH. (541) 296-9177

**NOTE:**  
 "THIS MAP IDENTIFIES THE LOCATION OF  
 THE WATER RIGHT ONLY AND IS NOT  
 INTENDED TO PROVIDE DIMENSIONS OR  
 LOCATE PROPERTY OWNERSHIP LINES.

**FINAL PROOF SURVEY**  
**WATER RIGHT TRANSFER, EXCHANGE OF PRIORITY**  
 SCALE: 1" = 1320'