
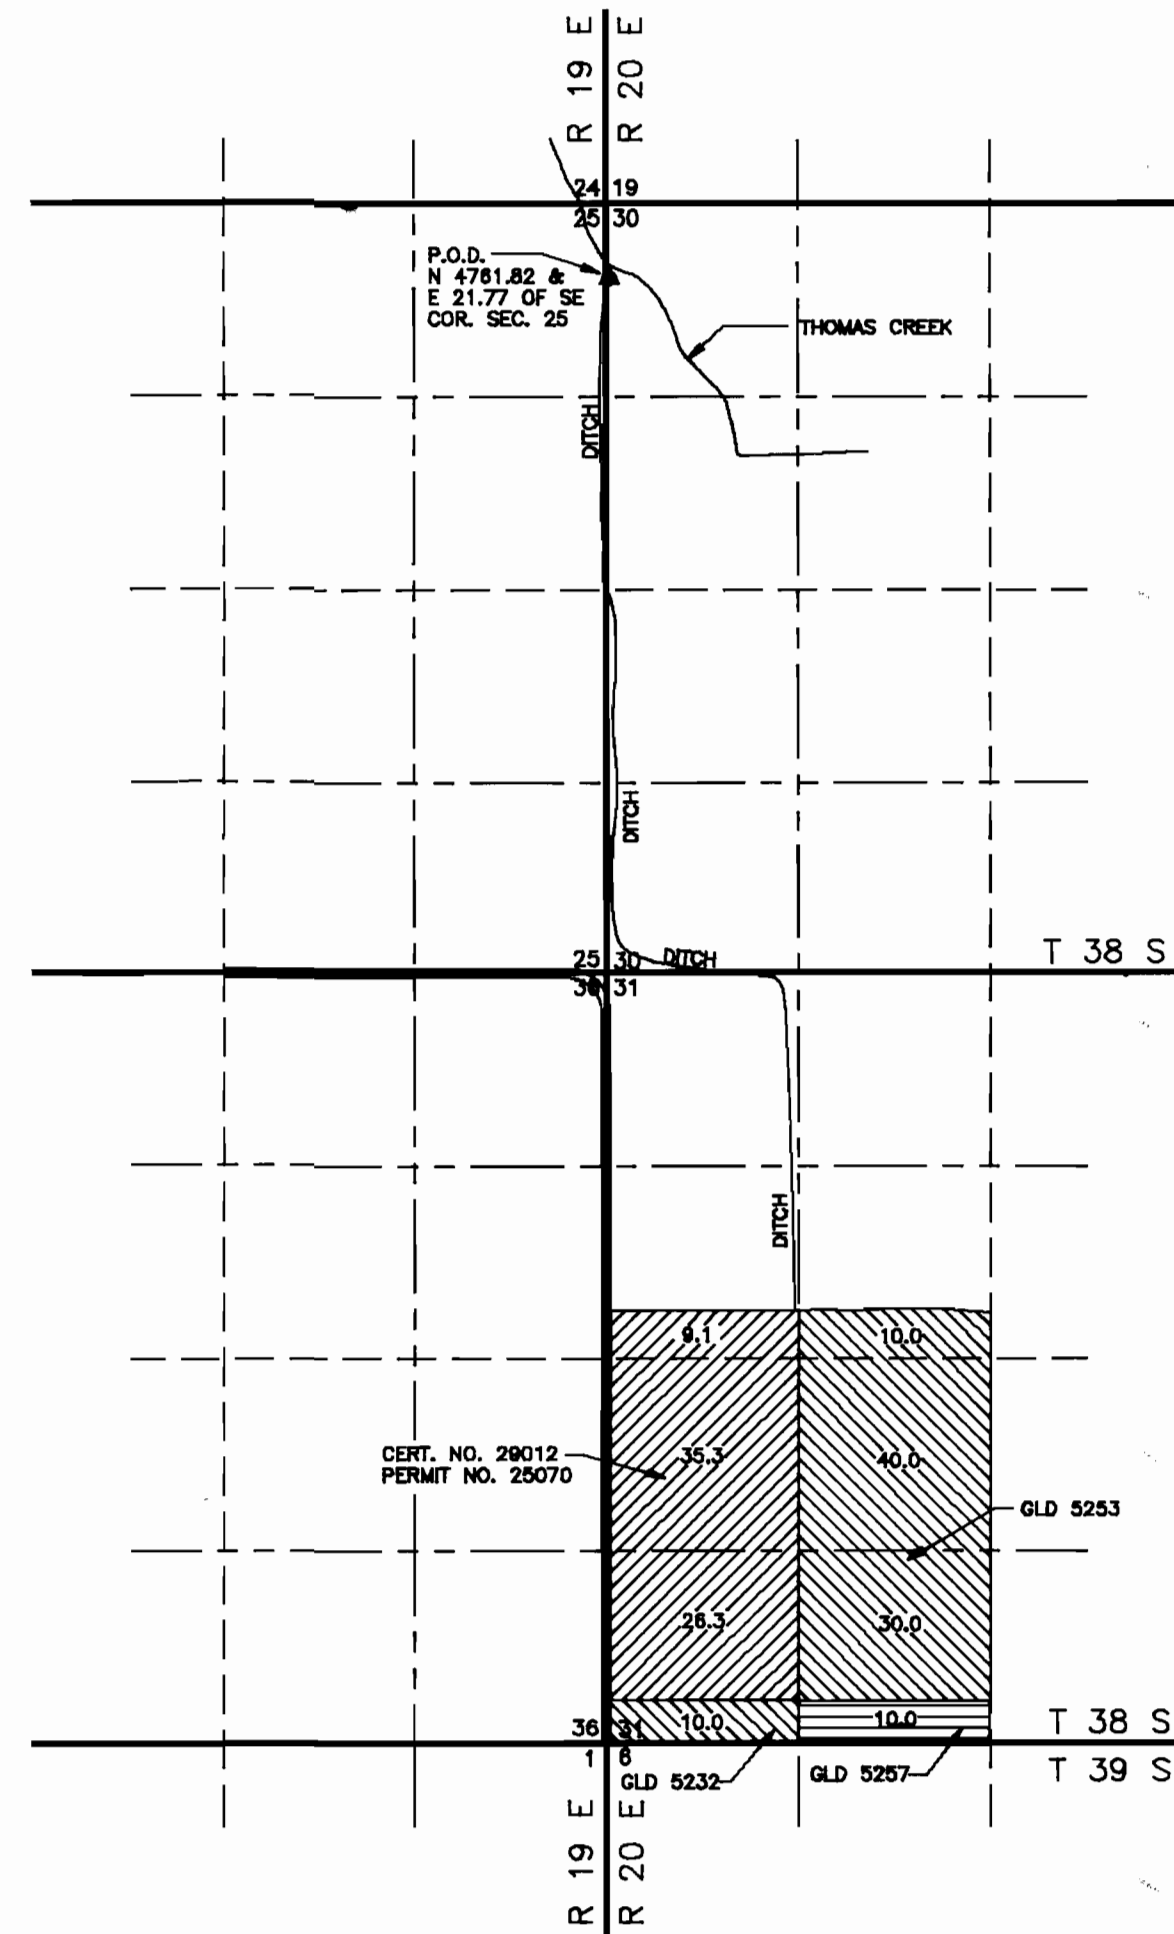


FINAL PROOF SURVEY FOR ERWIN ABRAMSON TRANSFER # 6194

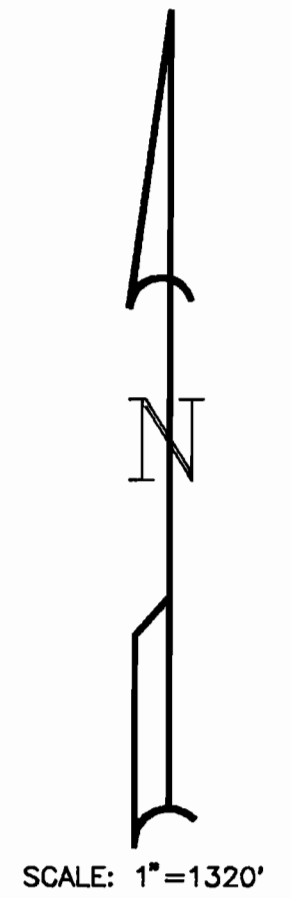

NOTE: IRRIGATED ACRES NOT VERIFIED THIS SURVEY.

LEGEND

- SECTION LINE
- - - - - 1/4 SECTION LINE
- · - · - 1/16 SECTION LINE
- ▲ POINT OF DIVERSION
- ==== HIGHWAY

NOTE: PREPARATION OF THIS MAP IS FOR IDENTIFYING PROPOSED WATER RIGHTS ONLY. IT HAS NO INTENT TO PROVIDE LOCATIONS OR DIMENSIONS OF PROPERTY BOUNDRIES..

DITCH LOCATION IN SW 1/4 OF SECTION 30 REVISED 2/7/91



PREPARED FOR:
ERWIN ABRAMSON
444 SOUTH H STREET
LAKEVIEW, OR 97630

PREPARED BY:
ANDERSON ENGINEERING AND SURVEYING
618 SOUTH FIRST STREET
P.O. BOX 28
LAKEVIEW, OREGON 97630
(503) 947-4407 FAX 947-2321