


# T.35 S., R.4 W., W.M.

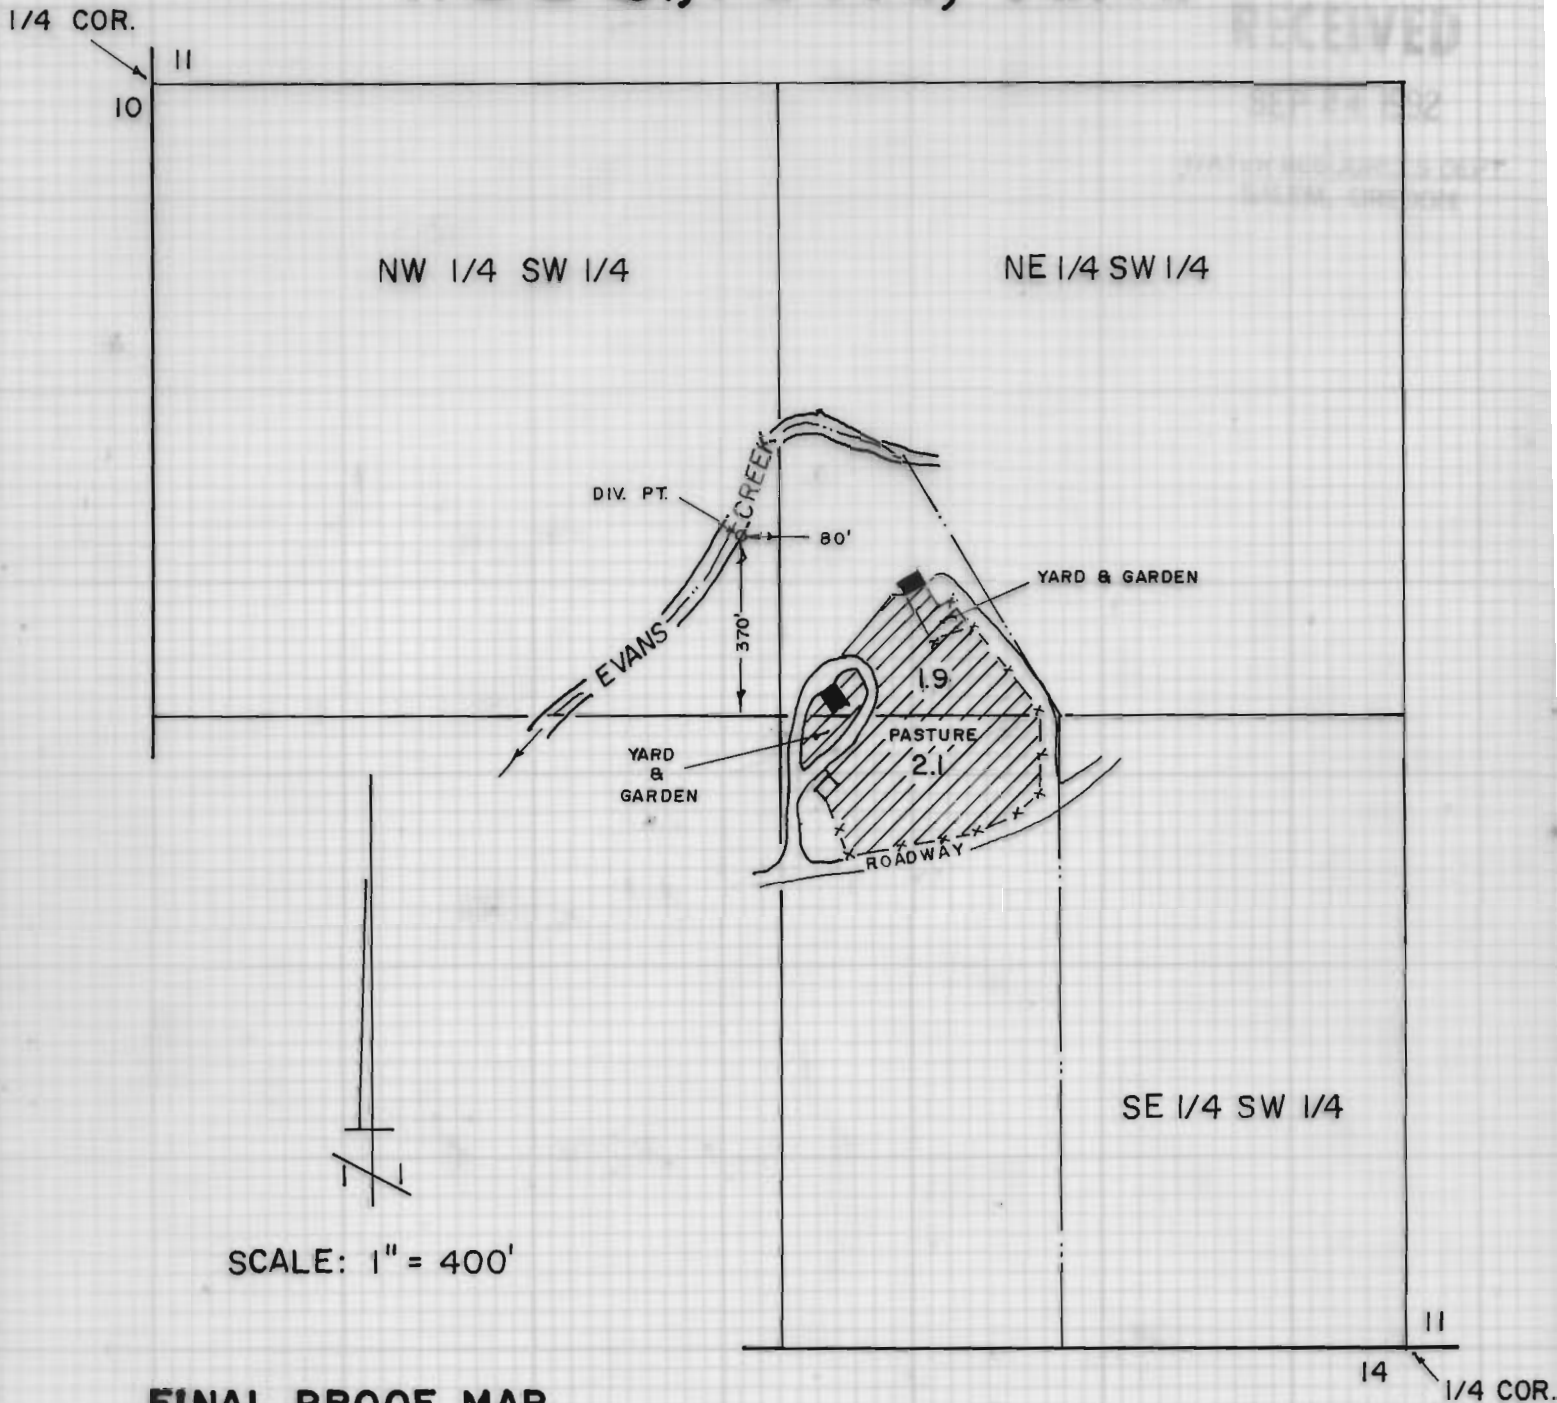


**FINAL PROOF MAP**

TRANSFER No. T-6280

IN THE NAME OF  
LARRY P. MENTEIER

NOTE: THIS MAP HAS BEEN PREPARED  
FOR WATER RIGHT PURPOSES ONLY,  
NOT FOR PROPERTY BOUNDARY LOCATIONS

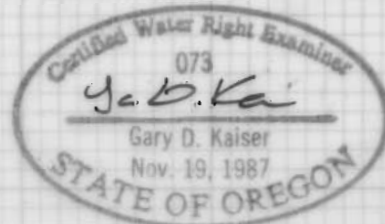

MAP PREPARED SEPTEMBER 17, 1992 BY GARY D. KAISER