

12 7  
13 18

SEC. COR. NW 1/4 NW 1/4


SW 1/4 NW 1/4

3020'

T. 36 S., R. 3 W.  
T. 36 S., R. 2 W.

GOV'T LOT 5

2" MAIN LINE

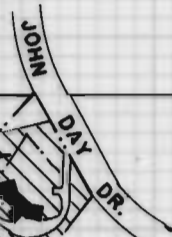

440'

1.3 PUMP

NEW DIV. PT.

GOV'T LOT 4  
(NW 1/4 SW 1/4)

ROGUE RIVER




SCALE: 1"=400'

**FINAL PROOF MAP**  
APPLICATION No. T-6293

IN THE NAME OF  
FRED OWEN, JR.

MAP PREPARED SEPTEMBER  
22, 1993 BY GARY D. KAISER

NOTE: MAP PREPARED FOR WATER  
RIGHT PURPOSES ONLY, NOT FOR  
PROPERTY BOUNDARY LOCATIONS.

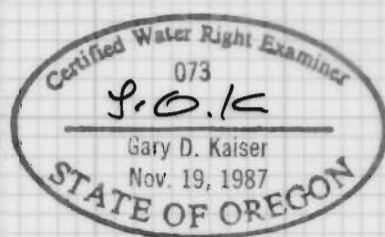

**RECEIVED**

SEP 30 1993

WATER RESOURCES DEPT.  
SALEM, OREGON