


T. 3 N., R. 28 E., W. M.

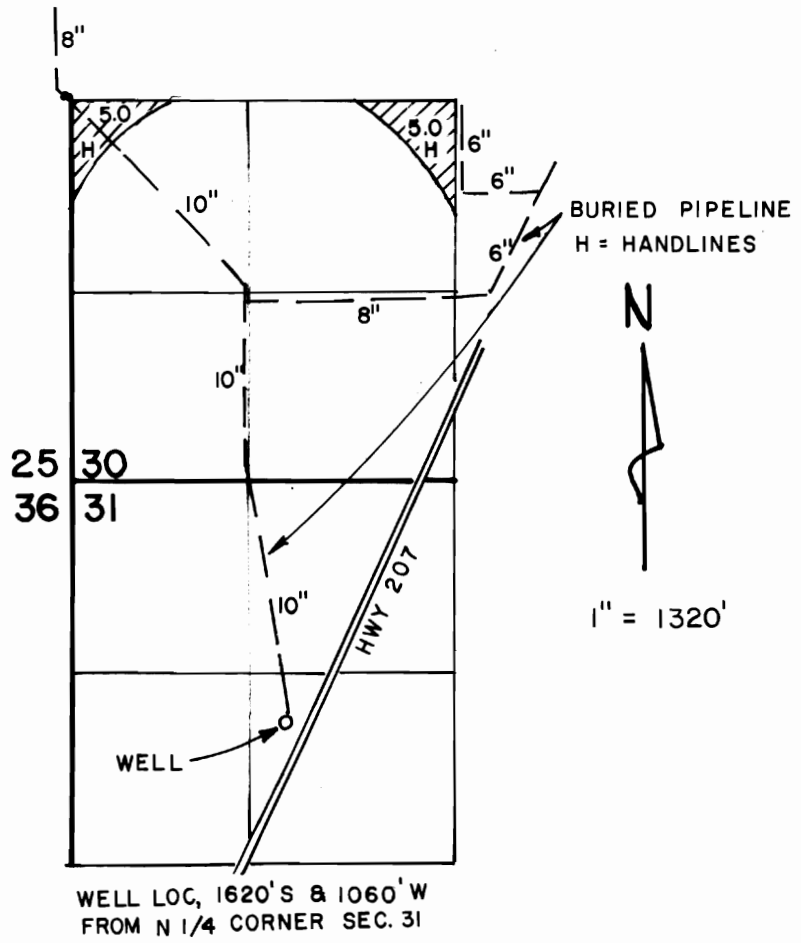

FINAL PROOF SURVEY

UNDER

Application No. T-6336

Permit No. G-7612

IN NAME OF

KENT & SHANNON MADISON

The preparation of this map was for the purpose of identifying the location of water right only, and has no intent to provide dimensions or locations of property ownership lines.

