
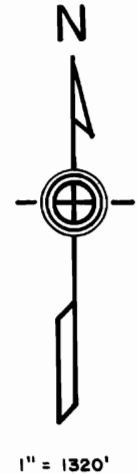


# Township 6 South, Range 1 East, W. RECEIVED

Portions of Sections 7 & 18


SEP 25 1992

WATER RESOURCES DIV.  
SALEM, OREGON

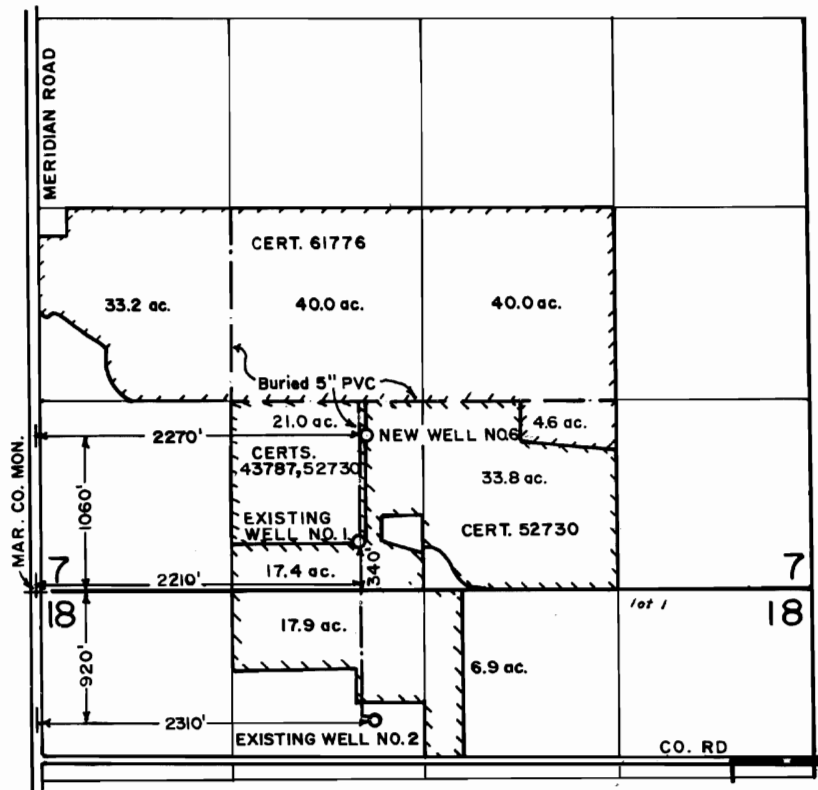

FINAL PROOF SURVEY  
under  
Transfer 6351  
in name of

DICKMAN FARMS, INC.  
SEPTEMBER 11, 1992

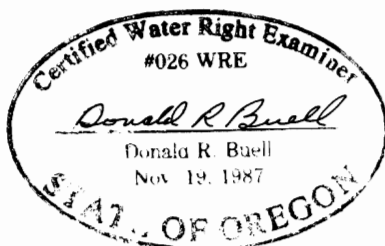

THIS MAP WAS PREPARED FOR THE PURPOSE OF IDENTIFYING THE LOCATION OF A WATER RIGHT ONLY AND IS NOT INTENDED TO PROVIDE LEGAL DIMENSIONS OR LOCATION OF PROPERTY OWNERSHIP LINES.