
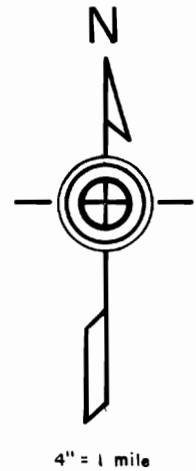


Township 6 South, Ranges 1 West & 1 East, W.M.

Portions of Sections 13 & 24 in Range 1 West
& Sections 18 & 19 in Range 1 East

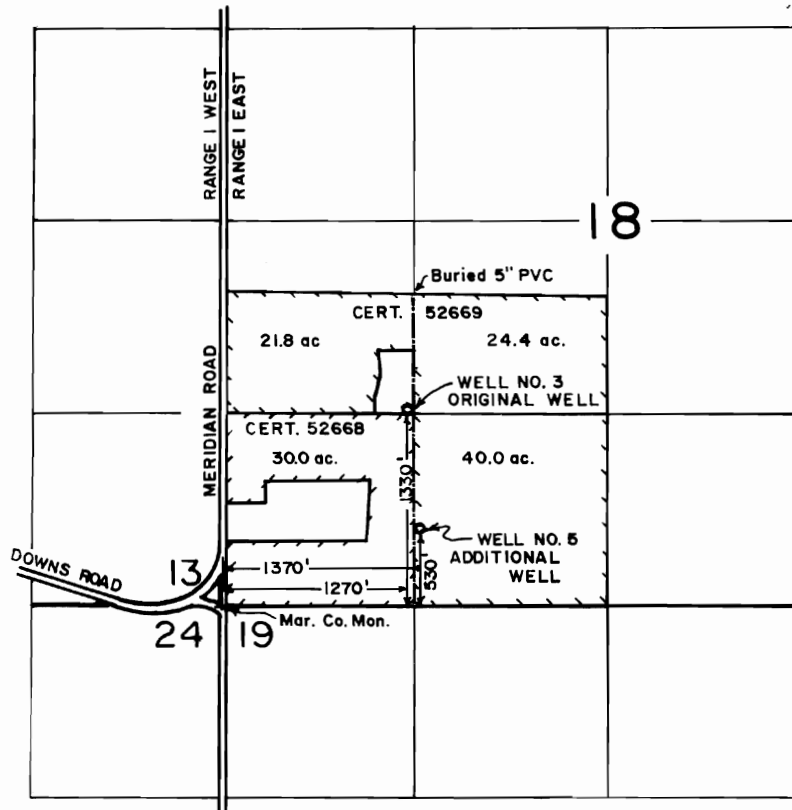

FINAL PROOF SURVEY
under
Transfer 6352
in name of

DICKMAN FARMS, INC.
JUNE 10, 1992

RECEIVED

JUN 15 1992

WATER RESOURCES DIVISION
SALEM, OREGON



THIS MAP WAS PREPARED FOR THE
PURPOSE OF IDENTIFYING THE
LOCATION OF A WATER RIGHT ONLY
AND IS NOT INTENDED TO PROVIDE
LEGAL DIMENSIONS OR LOCATION OF
PROPERTY OWNERSHIP LINES.