


T 1 & 2 S R 39 E WM

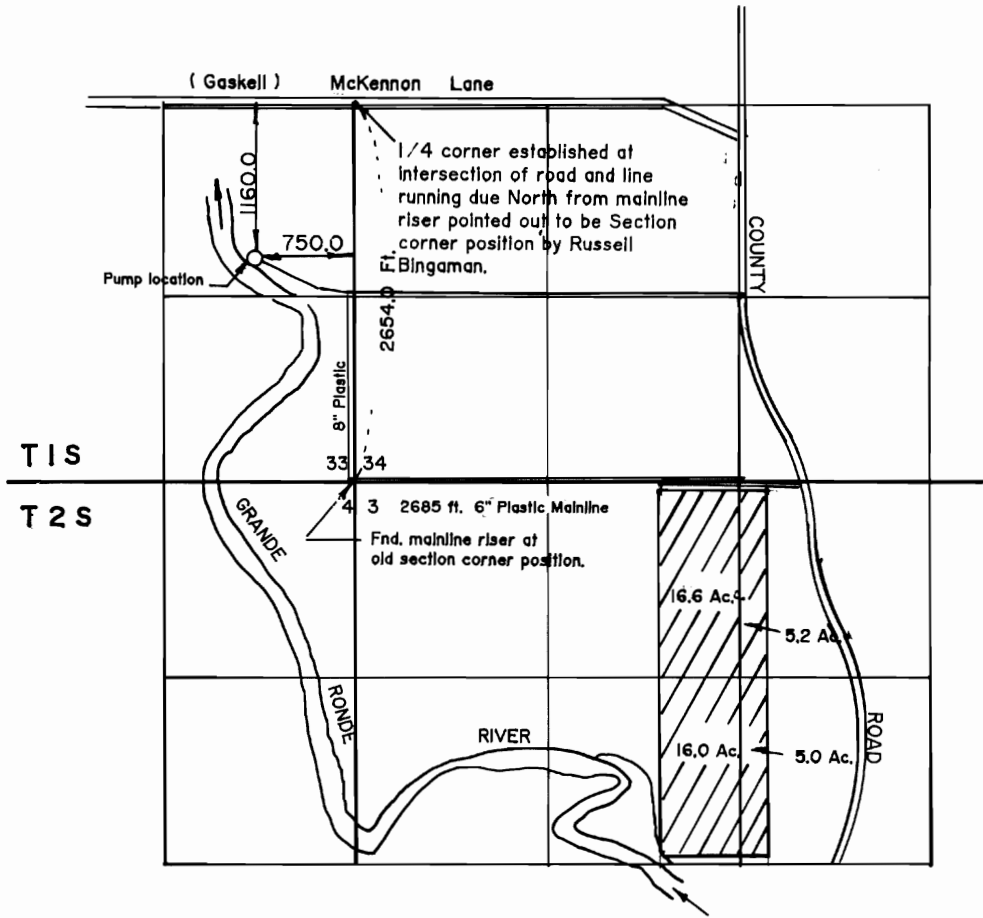

SCALE 1" = 1320 Ft.


FINAL PROOF SURVEY UNDER TRANSFER NUMBER T - 6358

IN THE NAMES OF

RUSSELL AND PATRICIA BINGAMAN

SURVEYED NOVEMBER 22, 1991

By Gregory T. Blackman

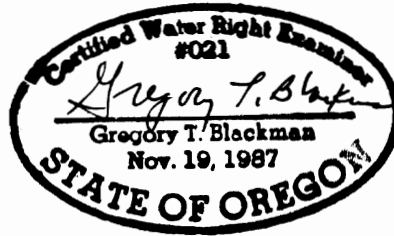

NOTE: The preparation of this map was for the purpose of identifying the location of the proposed water right and has no intent to provide dimensions or location of property ownership lines.