


T. 6 S., R. 38 E., W.M.

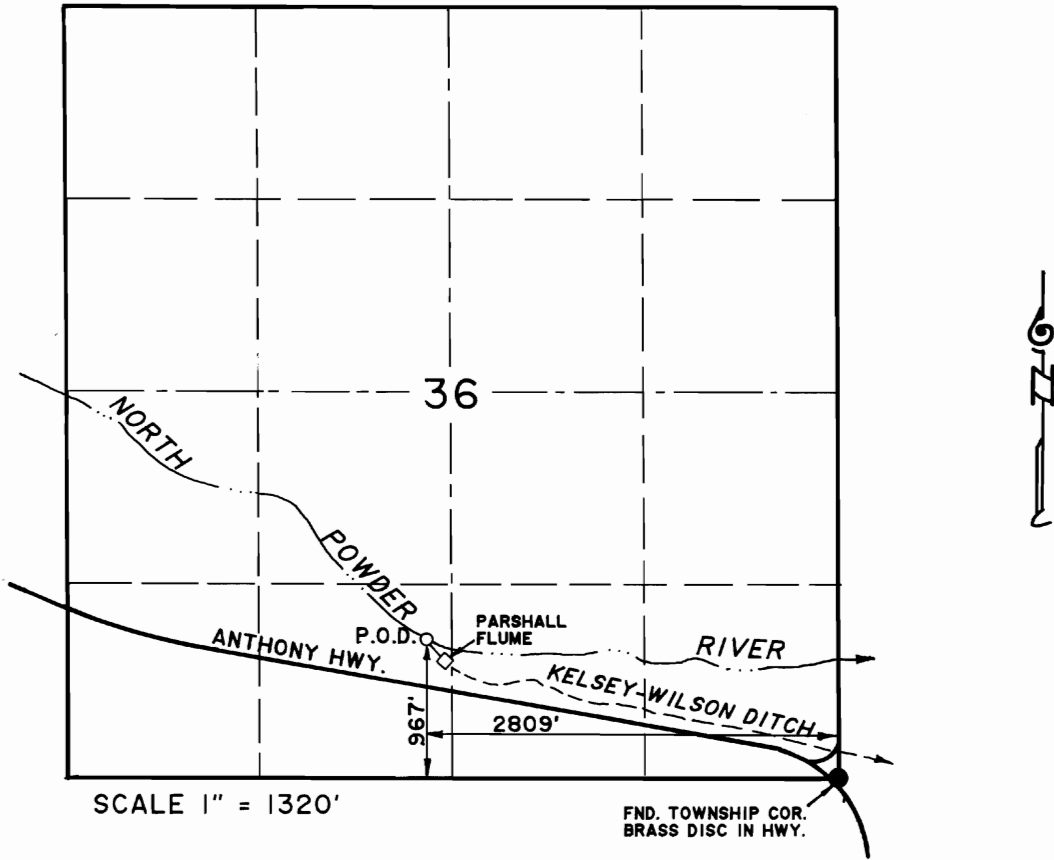

THE PURPOSE OF THIS MAP IS FOR IDENTIFYING THE LOCATION OF THE WATER RIGHT ONLY AND IS NOT INTENDED TO PROVIDE LEGAL DIMENSIONS OF PROPERTY OWNERSHIP LINES.

## FINAL PROOF SURVEY

Transfer No. T-6365

IN NAME OF

LOUIS E. MARKS

Surveyed January 28, 1993

