



T. 33 S., R. 1 E., W. 1 M.

FINAL PROOF MAP


APPLICATION NO. T-6367

IN THE NAME OF

ALBERTINA P. SOUZA

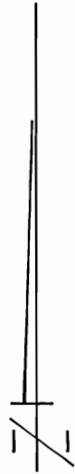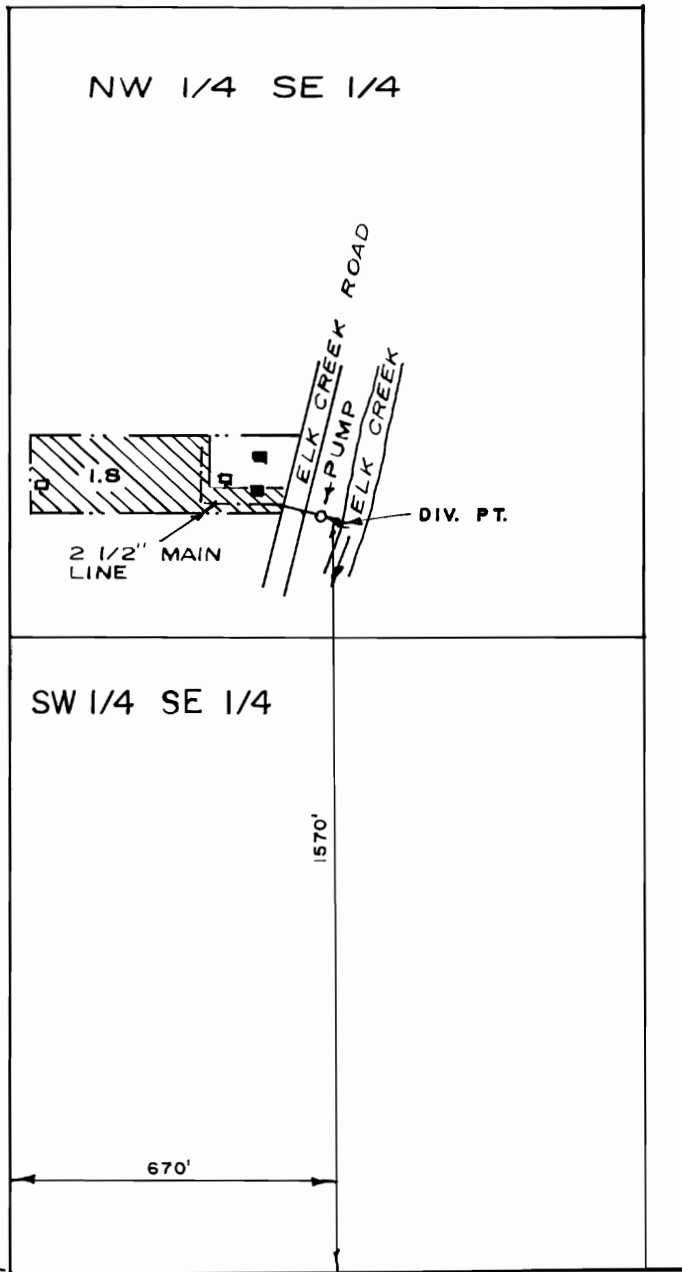

SCALE: 1" = 400'

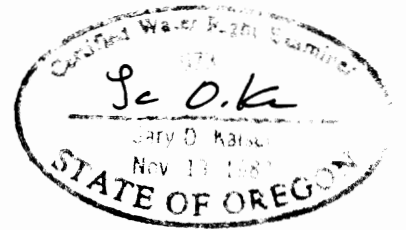

NOTE: THIS MAP HAS BEEN PREPARED FOR WATER RIGHT PURPOSES ONLY, NOT FOR PROPERTY BOUNDARY LOCATIONS

MAP PREPARED SEPTEMBER 25, 1991 BY GARY D. KAISER
ADDITIONS DECEMBER 22, 1992 *GDK*