



SECTION CORNER  
30 29  
31 32

SECTION LINE

NICHOLS MARKET ROAD

POINT OF DIVERSION  
1178' S., 1173' W. OF  
SECTION CORNER

0.56 Acres

SCALE: 1" = 400'


1/16 LINE


1/16 LINE

DESCHUTES RIVER

1/4 LINE

FINAL PROOF MAP;  
WILBUR WRIGHT T-6378  
T 16 S., R 12 E. W.M.  
SECTION 31  
DESCHUTES CO., OR.

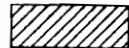 = Irrigated Area

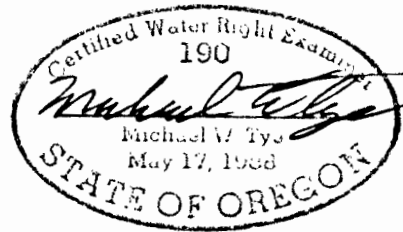

I, Michael W. Tye, Certified Water Right Examiner in the State of Oregon, hereby certify the above Final Proof map was prepared under my direct supervision.

The preparation of this map is for the purpose of identifying the location of the water right only and has no intent to provide dimensions or locations of property ownership lines.

Scale 1" = 400' | Date 8-6-91 | Survey by MT & LL | Drawn by LWL | Order No. 2716

**Sun Country Engineering & Surveying, Inc.**  
61555 SE PARRELL ROAD, BEND, OREGON 382-8882