


T. 2 N. R. 27 E. W. M.

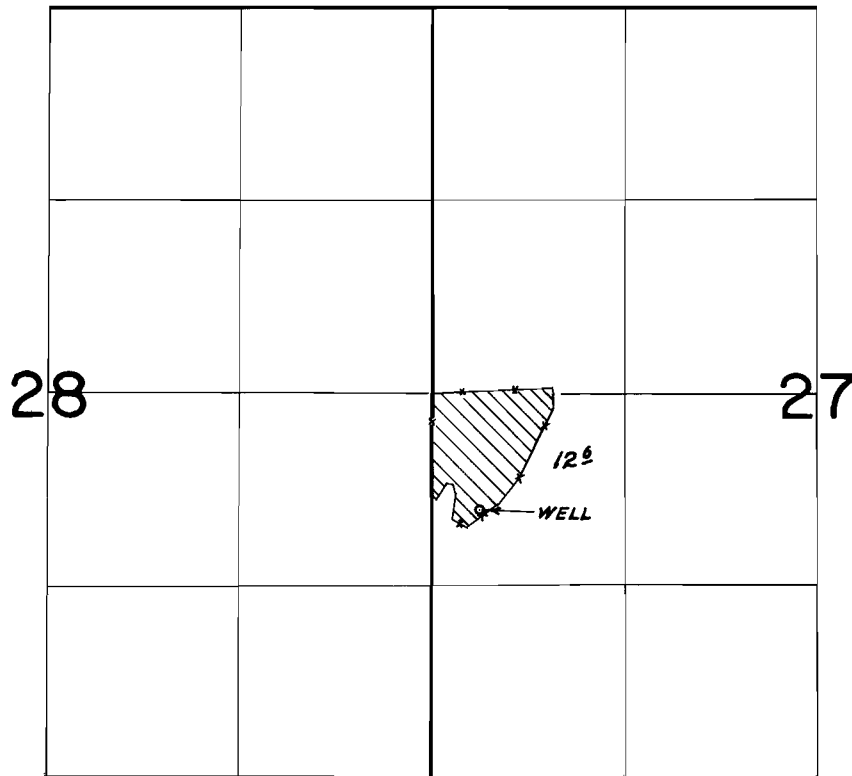

WELL LOC. 790' S & 330' E FROM W 1/4 COR. SEC. 27

FINAL PROOF SURVEY
UNDER

Application No. G-4073 Permit No. G-3816
IN NAME OF

THOMAS A. & JESSIE L. ASHBECK

Surveyed SEP. 2, 1971, by L. E. Gould