


**Proof Survey Map
Transfer T-6404
T 35 S & T 36 S, R 2 W, W.M.**

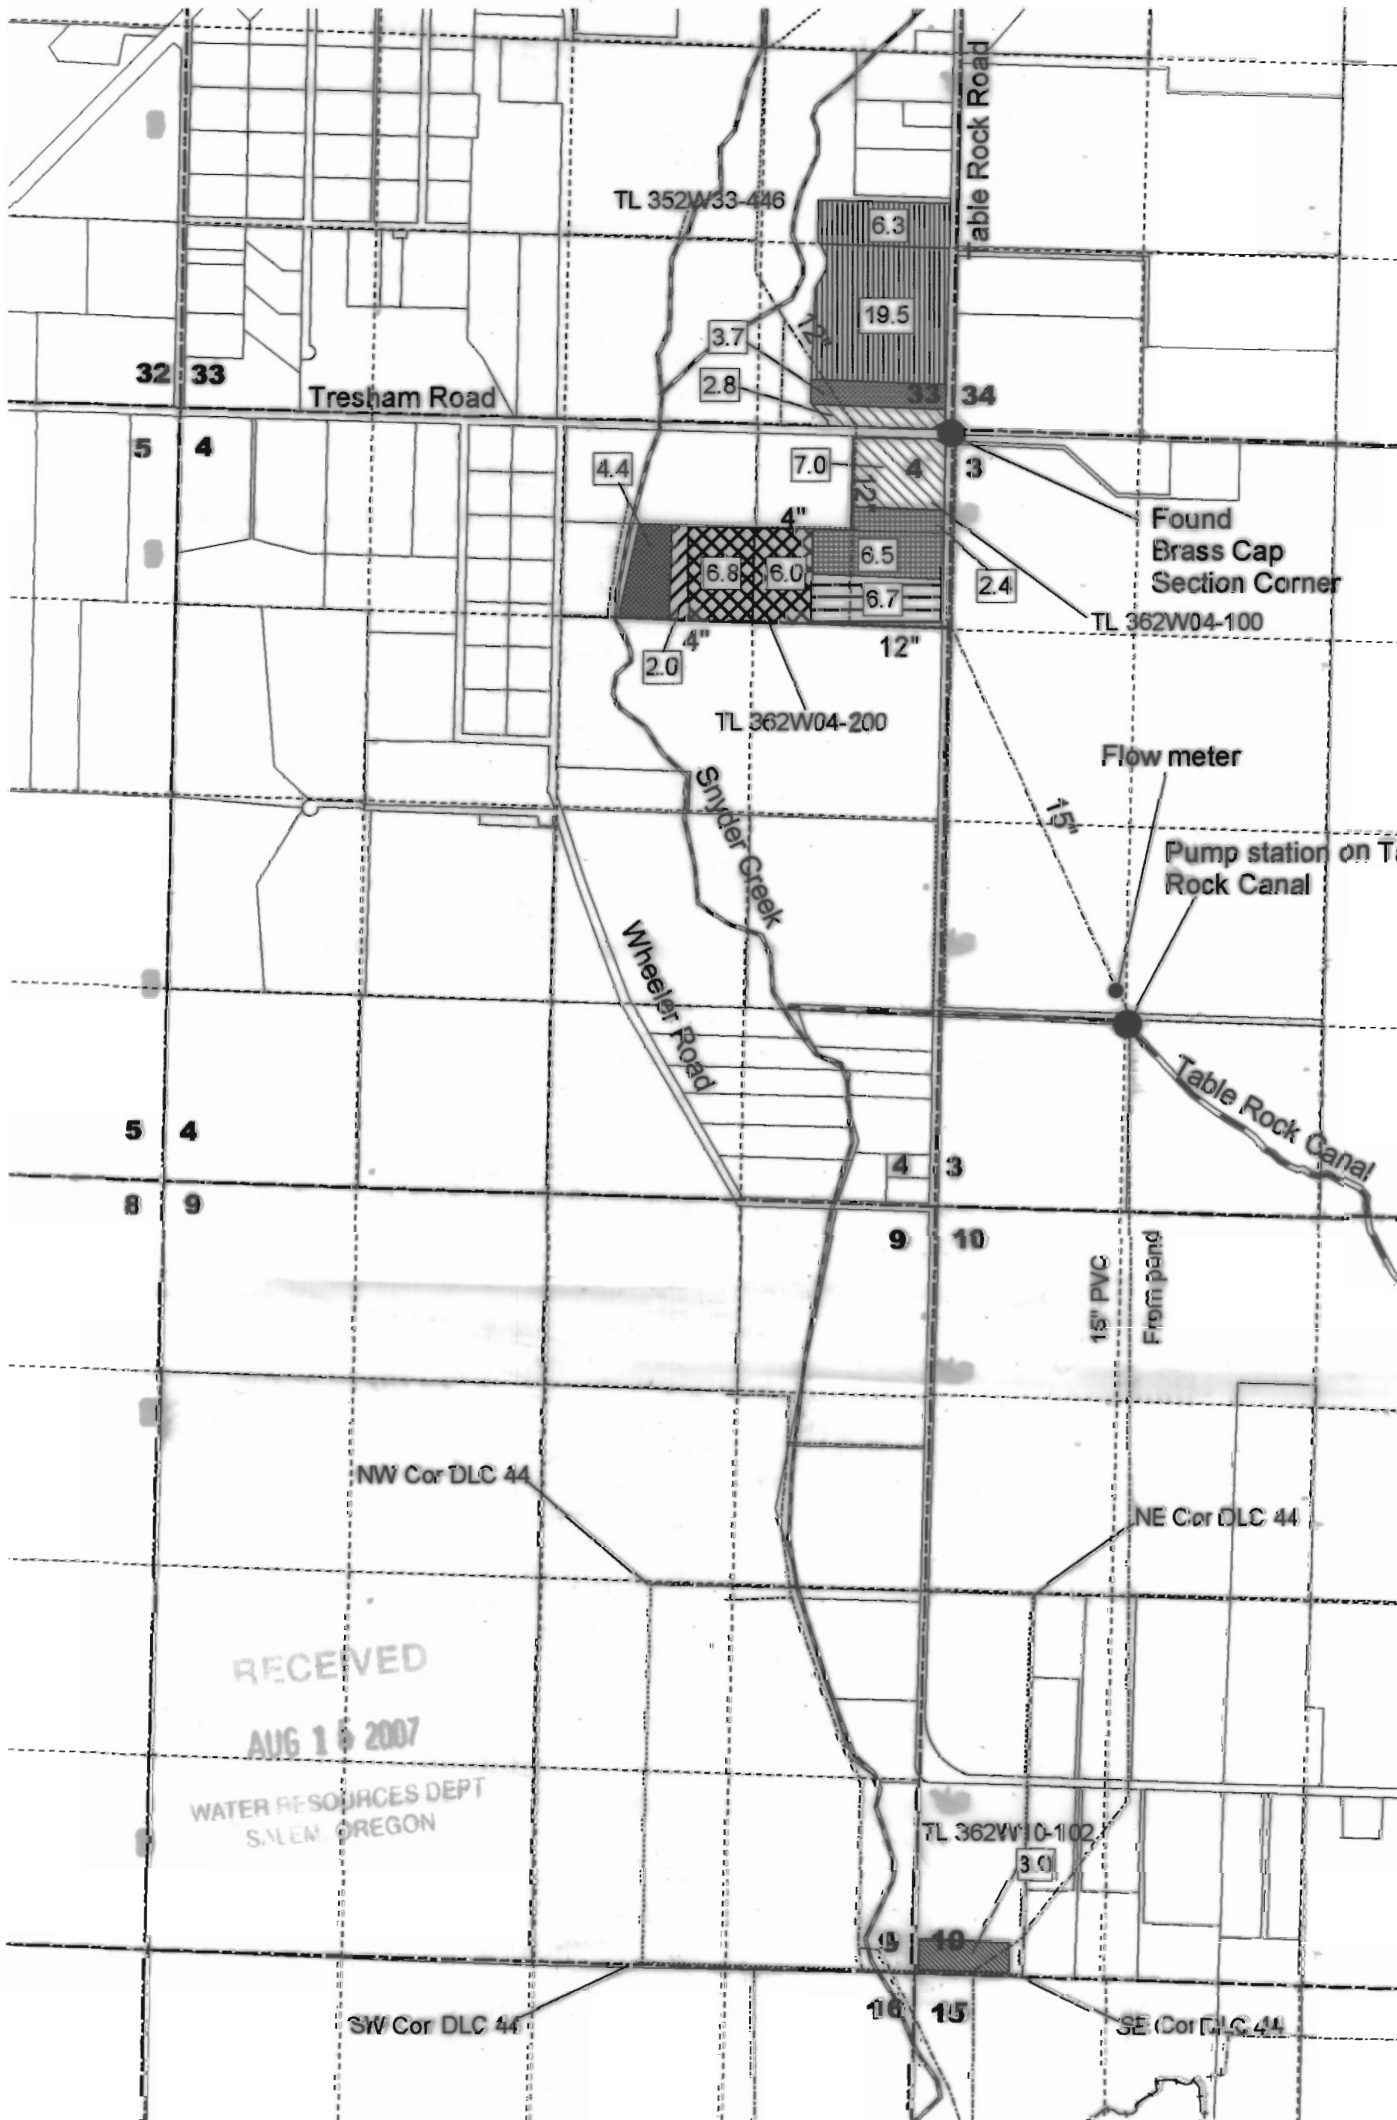

Legend

- "TO" Cert 36767
- "TO" Cert 32751
- "TO" Cert 32750
- "TO" Cert 32745
- "TC" Cert 32736
- "TC" Cert 32733
- "TO" Cert 32730
- "TO" Cert 32729
- "TO" Cert 32728
- PVC pipe line
- Alum Main line
- Section line
- Quarter-quarter line
- Creek
- Table Rock Canal



RENEWAL DATE 12-31-07

Note: This map for water right purposes and not to be used for property line location



**All maps
Scale 1" = 1320'**

FARBER SURVEYING
 JO Box 5286 Central Point, Oregon 97502 Phone 541-664-5599 Fax 541-664-5688 Email farber@farbersurveying.com
 Farber & Sons, Inc. 431 Oak Street Central Point, Oregon Fax ID: 98-1057175

RECEIVED
AUG 1 9 2007
WATER RESOURCES DEPT
SALEM, OREGON

