T. 7 S., R. 38 E., W.M. T. 7 S., R. 39 E., W.M.

NEI/4SW1/4

DIV. PT

SWI/4SEI/4

DIV. PT.

1370'

DITCH

2900'

FINAL PROOF SURVEY

UNDER


TRANSFERS 6403 AND 6635

IN NAME OF

PETER W. SCHOENINGH JR.

SURVEYED APRIL 22, 1993

THE PURPOSE OF THIS MAP IS FOR IDENTIFYING THE LOCATION OF THE WATER RIGHT ONLY AND IS NOT INTENDED TO PROVIDE LEGAL DIMENSIONS OF PROPERTY OWNERSHIP LINES.

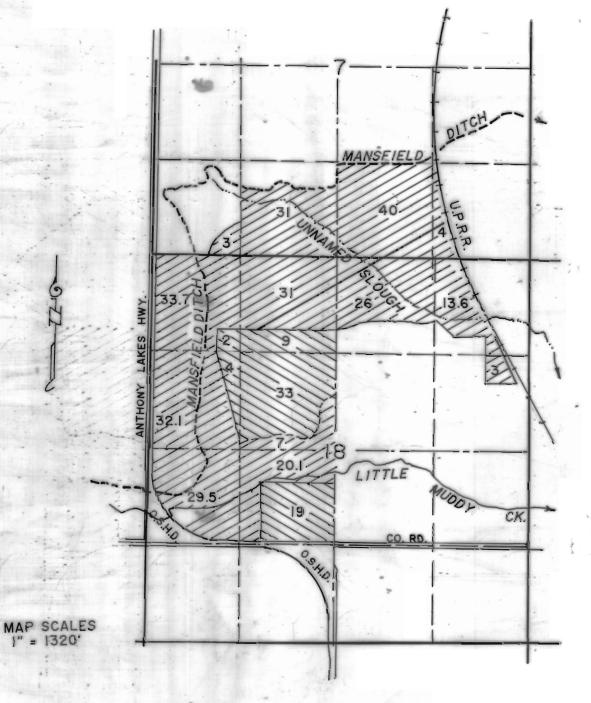



1887 PRIORITY



