


TOWNSHIP 4 NORTH, RANGE 28 EAST, W.M.

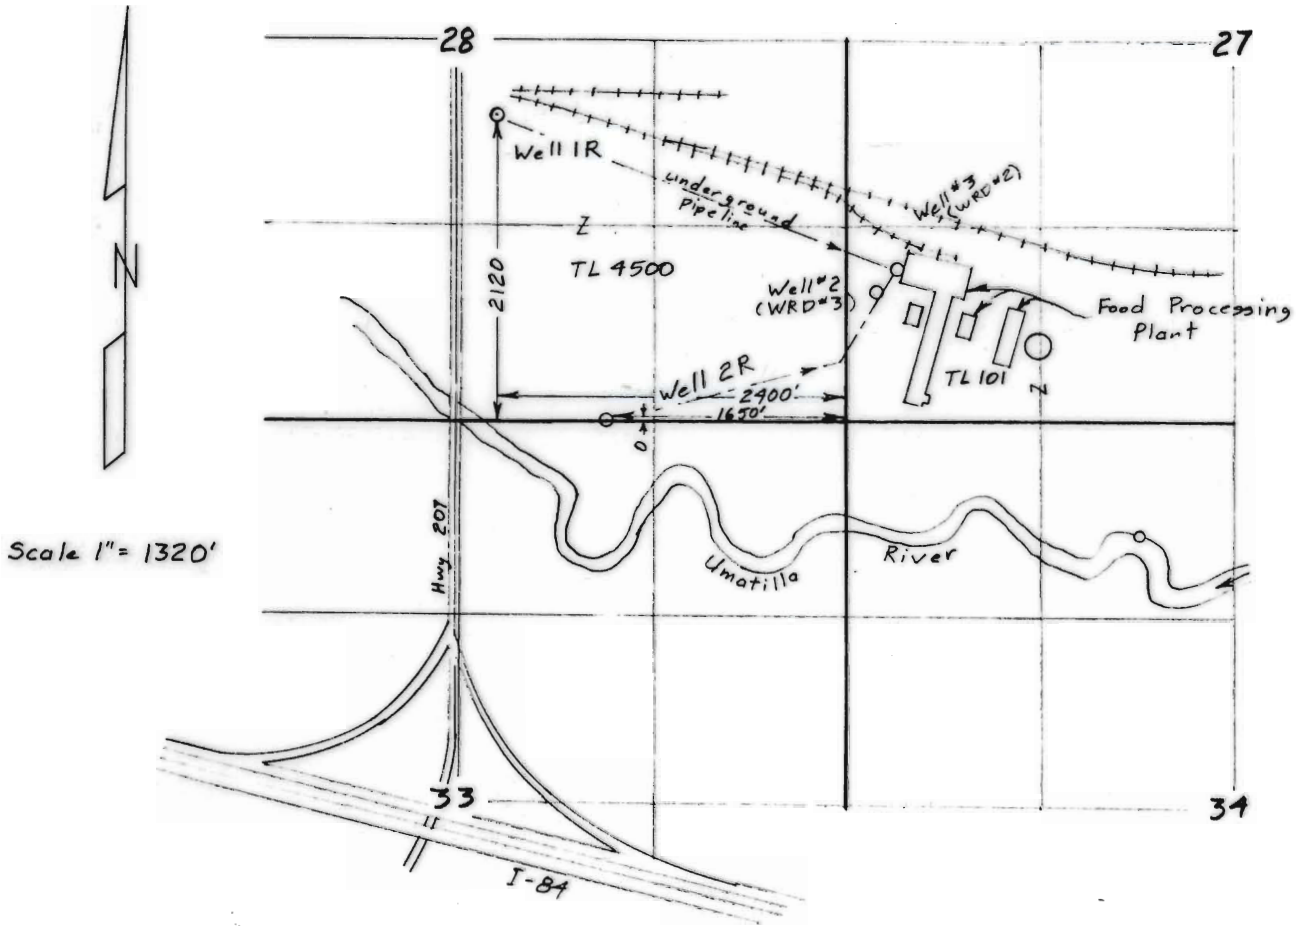

Surveyed Sep 30, 1997

Claim of Beneficial Use Map
for


J.R. SIMPLOT CO.

Under T-6416

RECEIVED

OCT 27 1997

**WATER RESOURCES DEPT.
SALEM, OREGON**

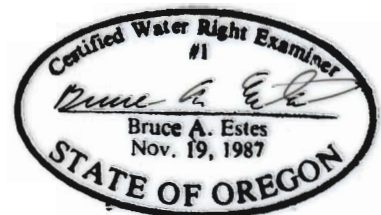

This map is for the purpose of locating a water right only and has no intent to provide legal dimensions or the location of property lines.

ESTES SURVEYS

6293 Sunnyview Rd. NE 60382 Arnold Rd.
Salem, OR 97305 Bend, OR 97702
(503) 585-7593 (503) 382-7391