
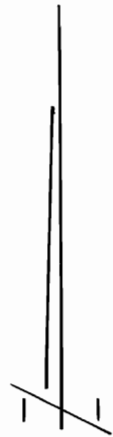


T.36 S., R.2 W., W.M.

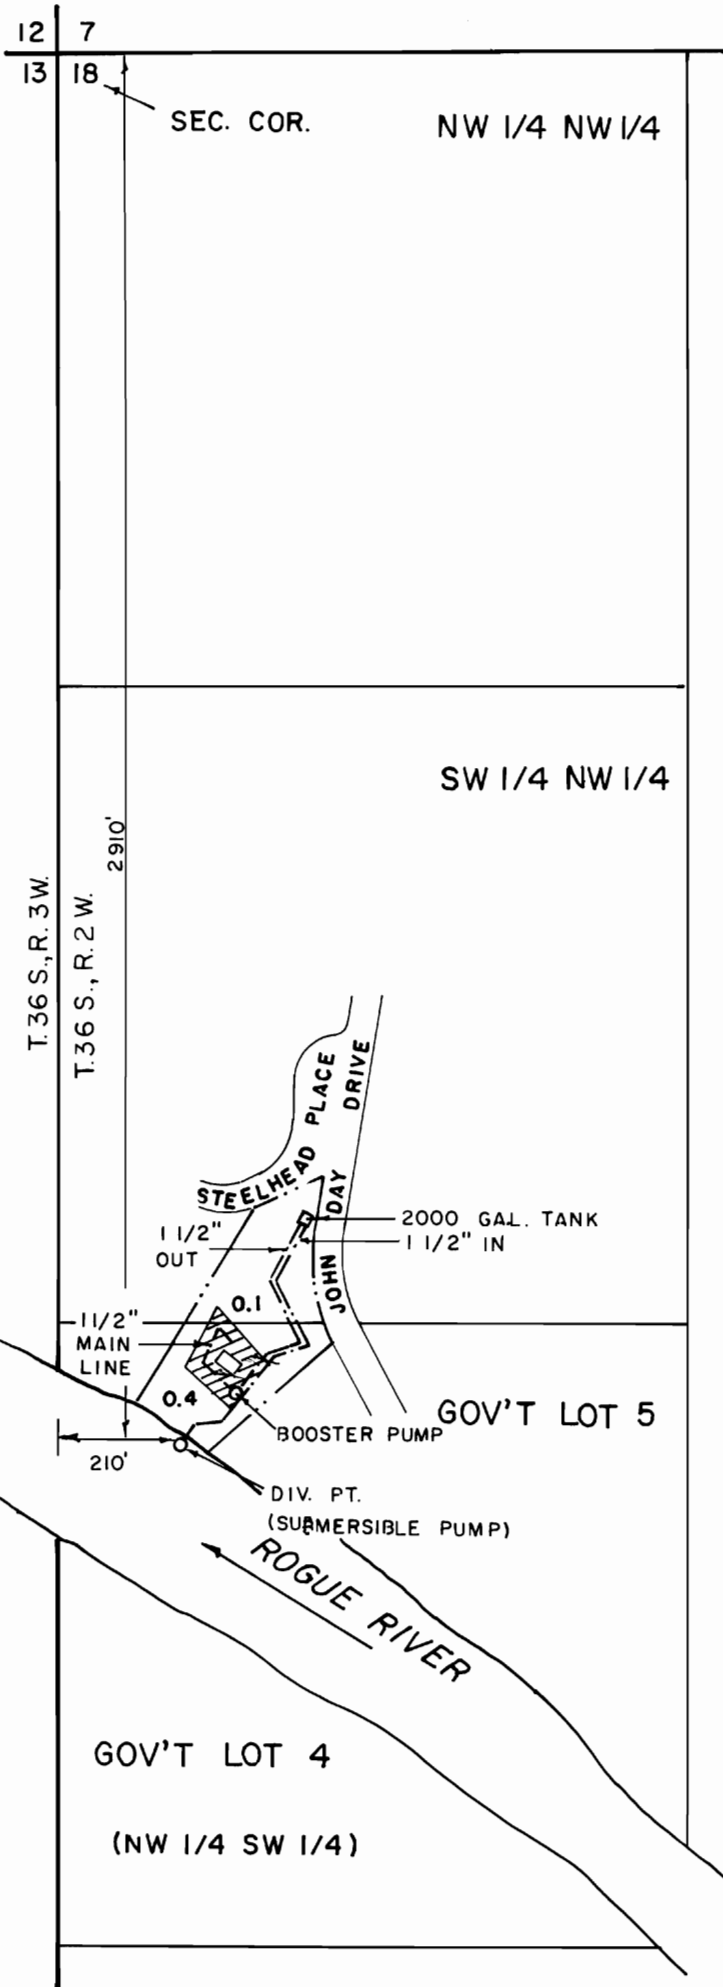

SCALE: 1" = 400'

FINAL PROOF MAP

APPLICATION No. T-6426

IN THE NAME OF
RICHARD C. SCHMIDT

MAP PREPARED SEPTEMBER
24, 1993 BY GARY D. KAISER

NOTE: MAP PREPARED FOR WATER
RIGHT PURPOSES ONLY, NOT FOR
PROPERTY BOUNDARY LOCATIONS



RECEIVED

WATER RESOURCES DEPT.
