



T. 15., R. 32&33E., W.M.

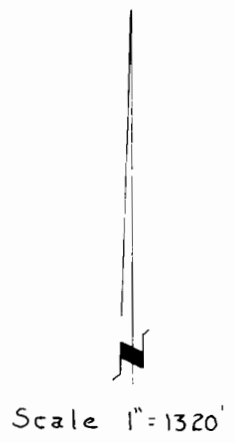

WELL LOCATED 440' N & 1200' W. FROM SE COR. SEC. 1

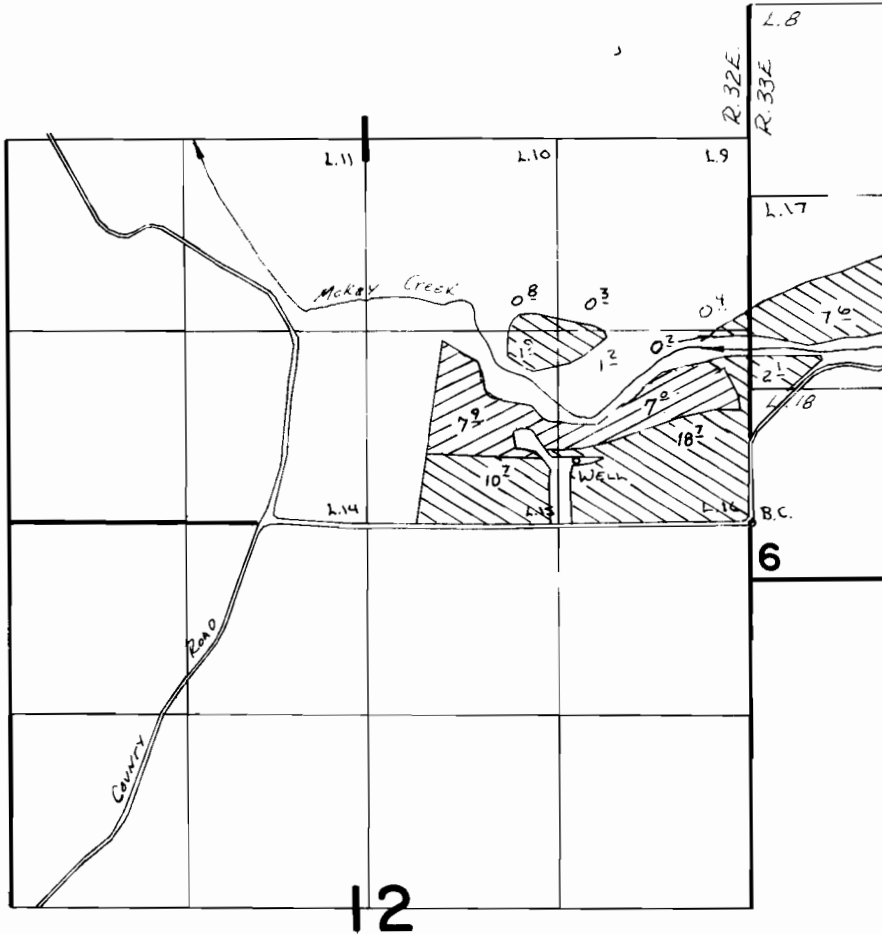

PRIMARY



SUPPLEMENTAL

FINAL PROOF SURVEY
UNDER

Application No. **G.6724** Permit No. **G.5470**.....
IN NAME OF

...**ALAN M. & RUTH G. INSKO**.....

Surveyed **2-15**..... **19.79**., by **R. Baldwin**.....
5-19..... **82**..... **V. Church**
5-7..... **84**.....