


SEC's. 13, 14, & 23,, TWP.1N. RANGE 12 E. W.M.

WASCO COUNTY, OREGON

RECEIVED

OCT-3 1994

WATER RESOURCES DEPT.  
SALEM, OREGON

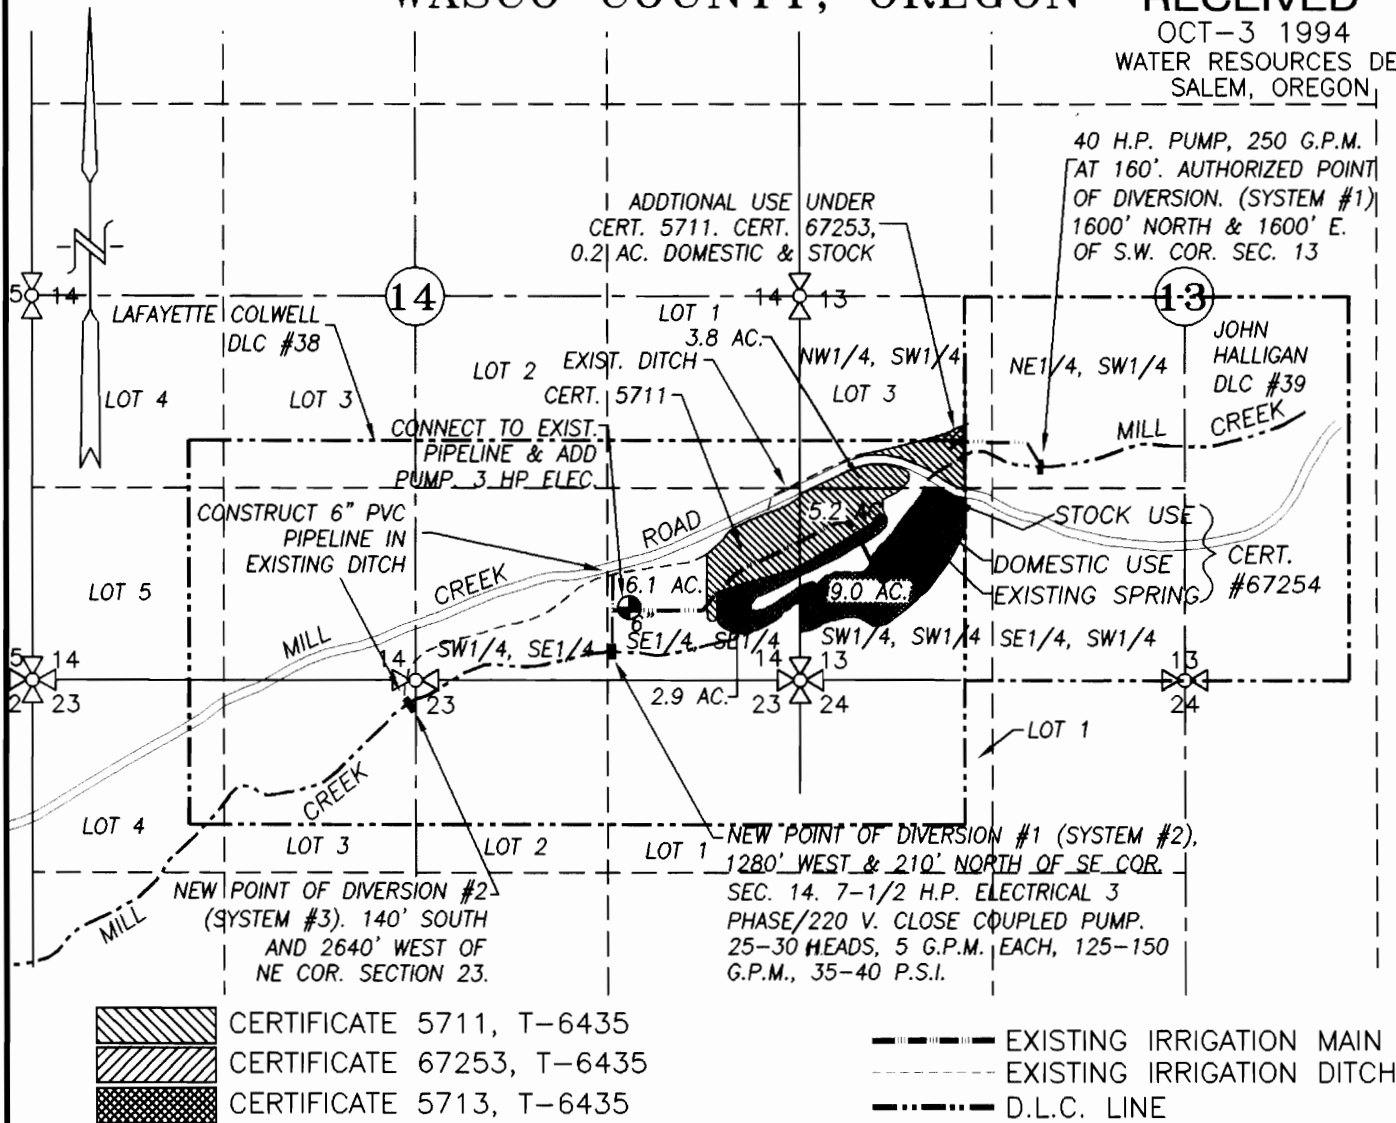

# FINAL PROOF SURVEY

## FOR ADDITIONAL POINT OF DIVERSION


SCALE: 1" = 1320'

APPLICATION No. T-6435

IN THE NAME OF:  
CHARLES SANDOZ

DATE: SEPTEMBER 20, 1994  
CAD UPGRADE: MAY 17, 2007

BY: **TENNESON ENGINEERING CORP.**  
409 LINCOLN STREET,  
THE DALLES, OREGON. 97058  
PH. (541) 296-9177  
FAX (541) 296-6657

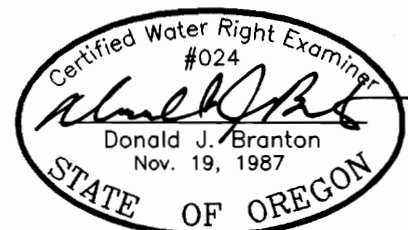

RENEW: 12/31/07

**NOTE:**

"THIS MAP IS NOT INTENDED TO  
PROVIDE DIMENSIONS OR LOCATIONS  
OF PROPERTY OWNERSHIP LINES."