

RECEIVED


SEP 30 1993

WATER RESOURCES DEPT
SALEM, OREGON


AREA OF BENEFICIAL USE
LOCATED IN T.3S., R.1E., W.M.
CLACKAMAS COUNTY, OREGON
SW 1/4 OF SE 1/4 SEC. 3 (LOT 1)
NE 1/4 OF NE 1/4 SEC 10 (LOT 1)
NW 1/4 OF NE 1/4 SEC 10 (LOT-11)



SCALE 1" = 400'

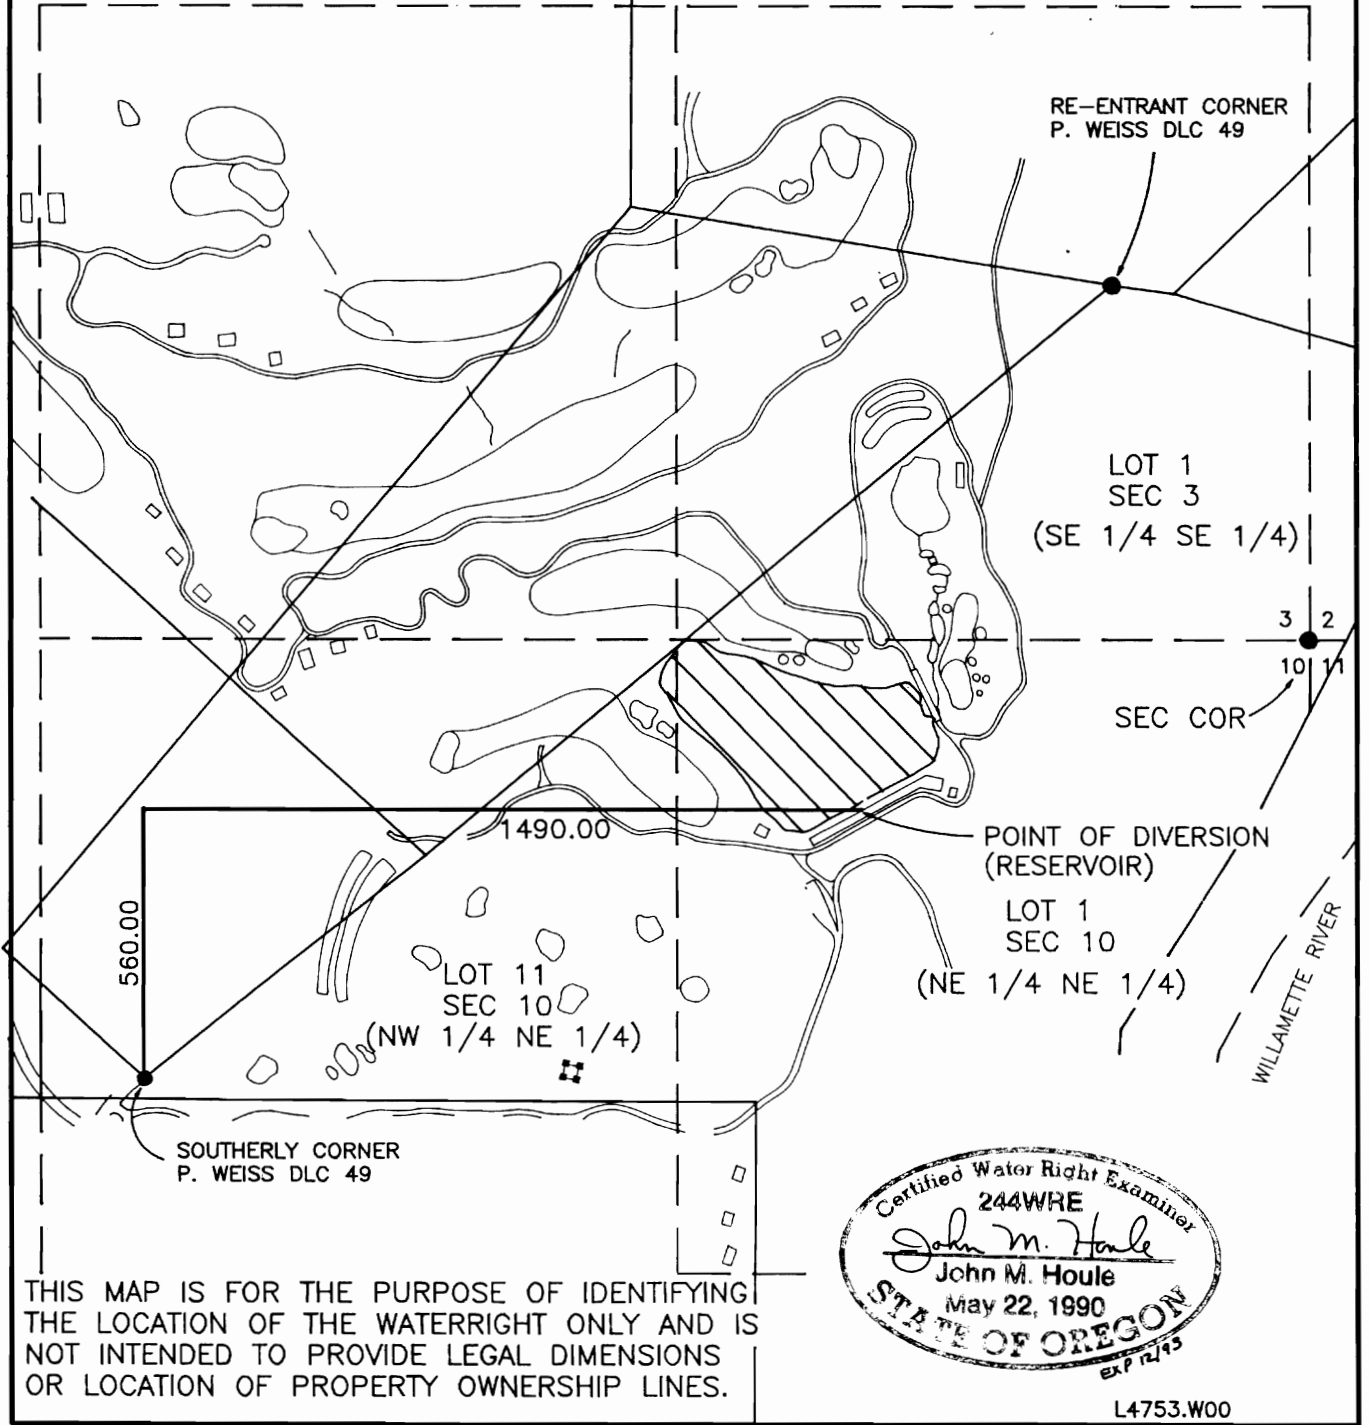

THIS MAP IS FOR THE PURPOSE OF IDENTIFYING THE LOCATION OF THE WATERRIGHT ONLY AND IS NOT INTENDED TO PROVIDE LEGAL DIMENSIONS OR LOCATION OF PROPERTY OWNERSHIP LINES.

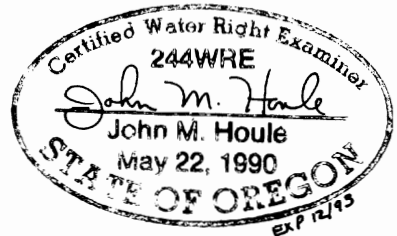

L4753.W00

FINAL PROOF SURVEY UNDER APPLICATION T-6444

APPLICANT: DAIOH INTERNATIONAL, USA CORP.
320 S.W. MARKET, SUITE 600
PORTLAND, OR 97204
(503) 294-2008

otak

incorporated

surveyors
engineers
planners

17355 S.W. BOONES FERRY ROAD
LAKE OSWEGO, OREGON 97035
(503)635-3618 FAX (503)635-5395