


T.10S., R.4W., W.M.

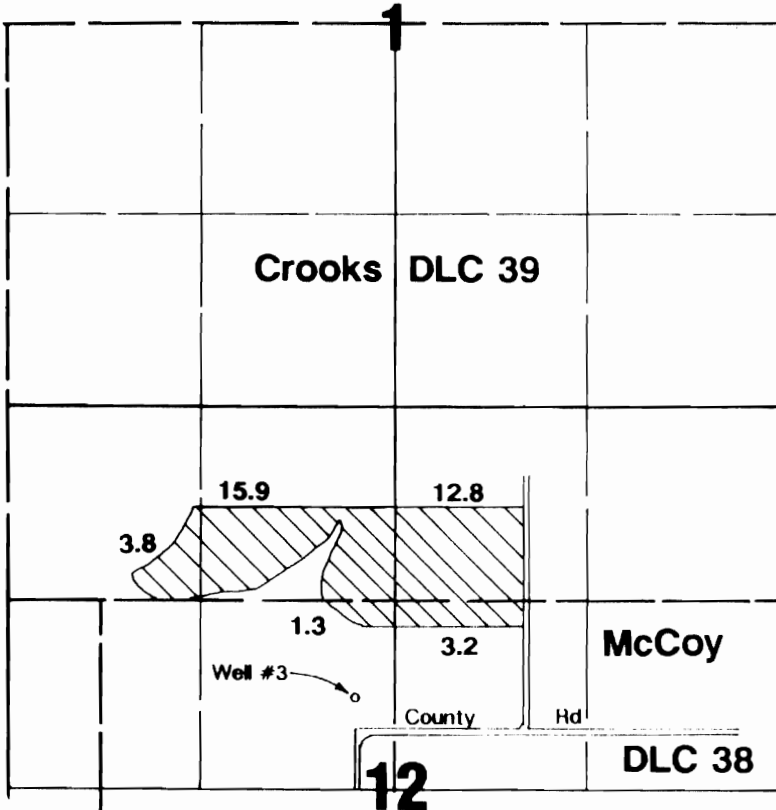

Well #3 located 640'N & 250'W from center Section 12.

Final Proof Survey

Transfer #T-6450

In Name Of

Burnel Harnisch

Surveyed by JM Schuette on April 19, 1993

