



Township 1 South, Range 4 East, W.M.  
 Portions of Sections 28, 29, 32 & 33

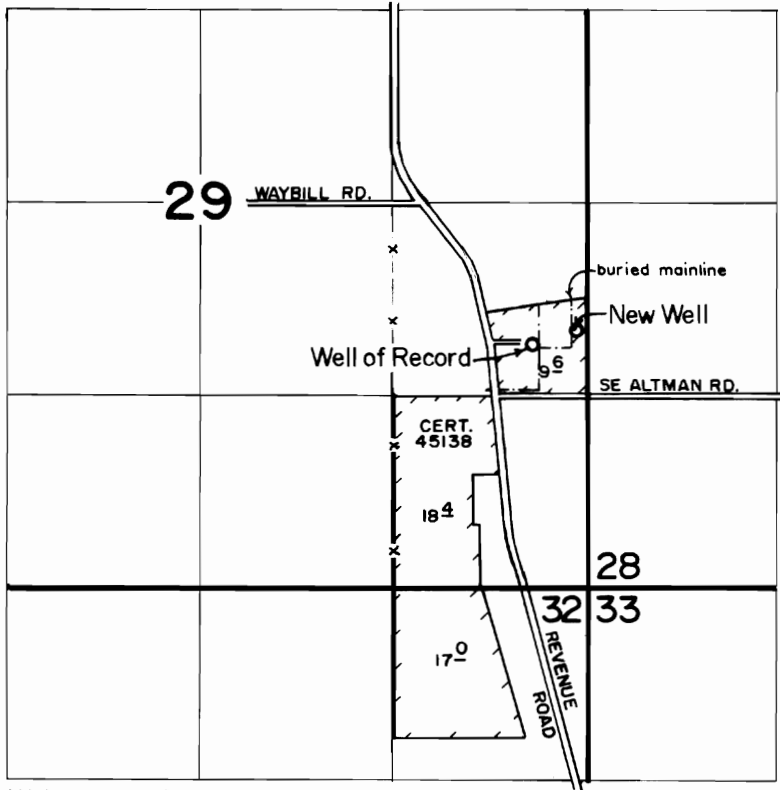

Wells located:  
 Well of Record - 1670' N. & 370' W. from SE cor. Sec. 29.  
 New Well - 460' N. & 1250' E. from NW cor. SE 1/4 SE 1/4, Sec. 29.

FINAL PROOF SURVEY  
 under  
 Transfer 6455  
 in name of  
 JAMES R. BUSHUE

September 24, 1993

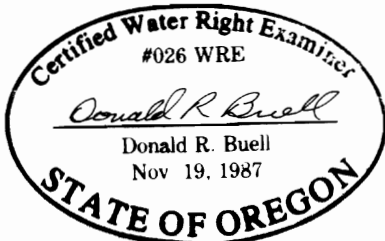

THIS MAP WAS PREPARED FOR THE PURPOSE OF IDENTIFYING THE LOCATION OF A WATER RIGHT ONLY AND IS NOT INTENDED TO PROVIDE LEGAL DIMENSIONS OR LOCATION OF PROPERTY OWNERSHIP LINES.