


T. 8 S. R. 4 W. W. M.

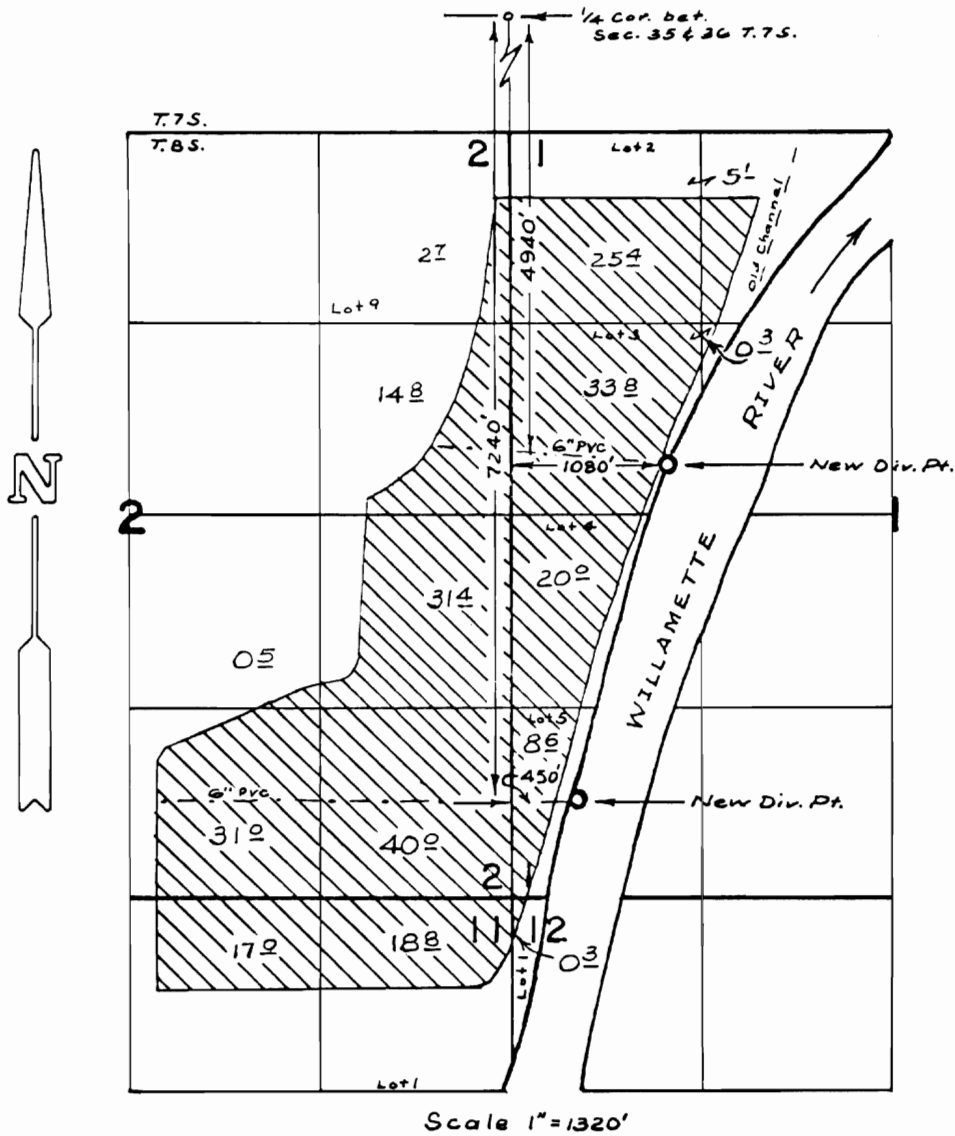

FINAL PROOF SURVEY  
 FOR  
 GREEN VILLA FARMS  
 TRANSFER No. T-6456  
 (PERMIT No. 29117)

THE PREPARATION OF THIS MAP IS FOR THE  
 PURPOSE OF IDENTIFYING THE LOCATION  
 OF THE WATER RIGHT ONLY AND HAS NO  
 INTENT TO PROVIDE DIMENSIONS OR LOCATION  
 OF PROPERTY OWNERSHIP LINES.

