

T. 30 S. R. 5 W. W.M.


6 5

MAP IS BASED ON BEST FIT
OF PREVIOUS WATER RIGHT MAPS

0 200 400 800

SCALE

SCALE 1"=400'

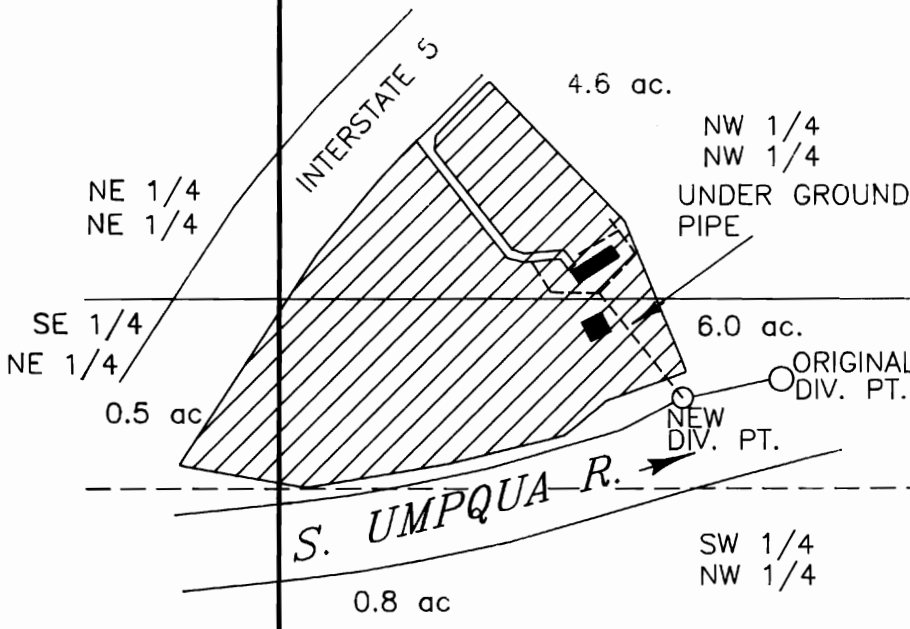

BAILEY DLC 40

WEAVER DLC 39

NEW DIV. PT. 1115 FEET NORTH AND 845 FEET EAST FROM THE EAST 1/4 CORNER SEC. 6
THIS MAP IS TO BE USED FOR WATER RIGHT PURPOSES ONLY

FINAL PROOF SURVEY FOR TRANSFER T-6493
IN NAME OF
NORMAN CANTRELL

DATE November 14, 1992

BY: WILLIAM J. RUPPERT
P.O. BOX 1564
MYRTLE CREEK, OR 97457