






FINAL PROOF SURVEY




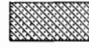
FOR TRANSFER OF WATER RIGHTS

TRANSFER NO. T-6499

LEGEND

-  SECTION LINE
-  1/4 SECTION LINE
-  1/16 SECTION LINE
-  EXISTING IRRIGATION DITCHES. WITH FLOW DIRECTION AS INDICATED. LAKEVIEW WATER USERS DITCH SYSTEM.
-  PIVOT CENTER.

CROSS HATCH DETAIL

- FROM
-  70.0 ACRES UNDER EXISTING LAKEVIEW WATER USERS CERTIFICATE #47469.
 -  1.5 ACRES UNDER EXISTING LAKEVIEW WATER USERS CERTIFICATE #47469.
- TO
-  AREA WHERE 70.0 ACRES* TRANSFERRED TO.
 -  AREA WHERE 1.5 ACRES TRANSFERRED TO.

T 40 S




SCALE: 1"=1320'



RENEWAL 12/31/99

NOTE: PREPARATION OF THIS MAP IS FOR IDENTIFYING PROPOSED WATER RIGHTS ONLY. IT HAS NO INTENT TO PROVIDE LOCATIONS OR DIMENSIONS OF PROPERTY BOUNDARIES.

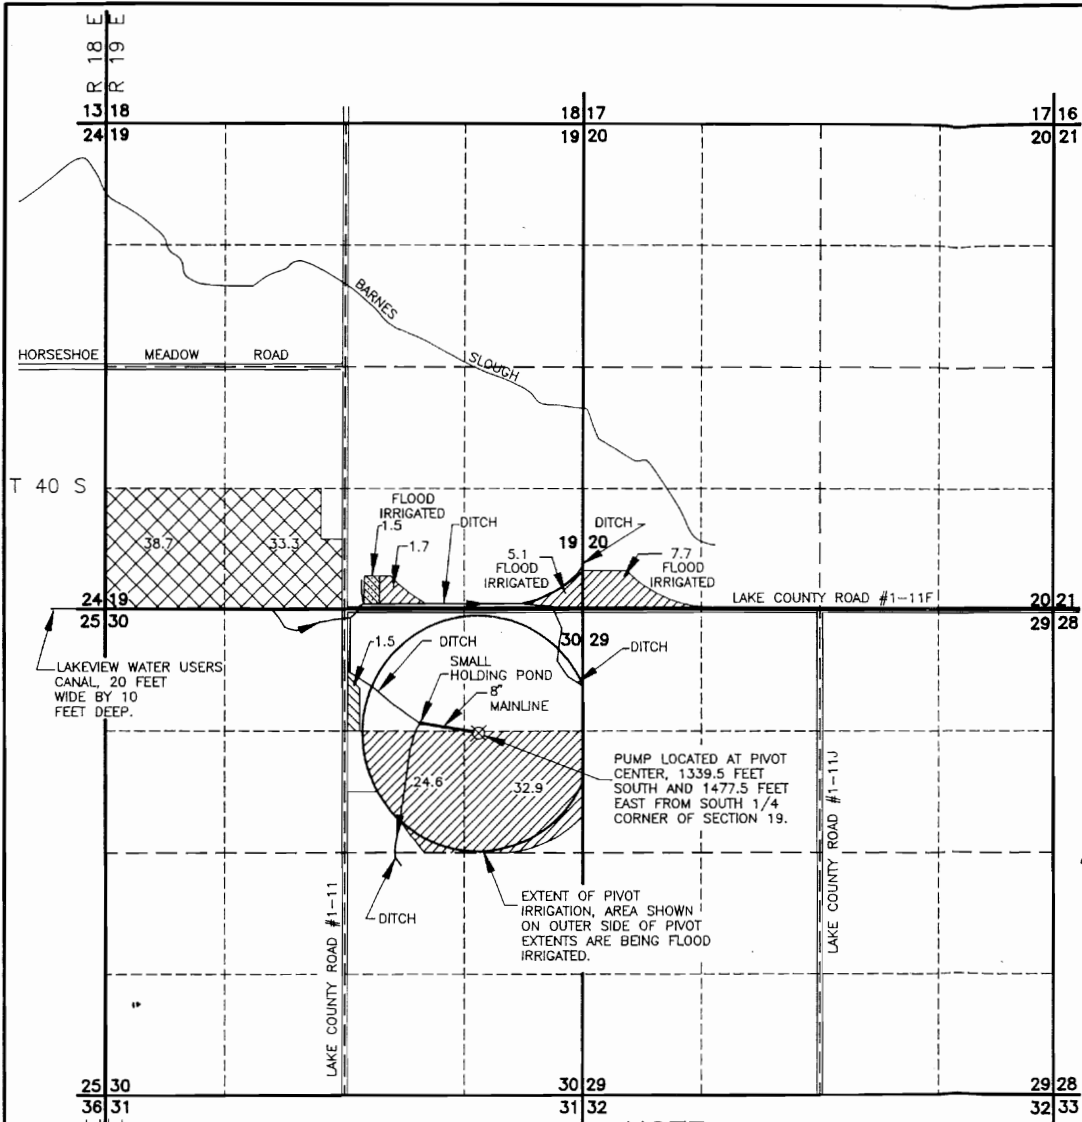

NOTE

SEE SITE REPORT FOR A MORE DETAILED DESCRIPTION OF THE IRRIGATION SYSTEM FOR THIS FINAL PROOF MAP.