


Township 5 South, Range 1 West, W. M.

Portions of Sections 34 & 35

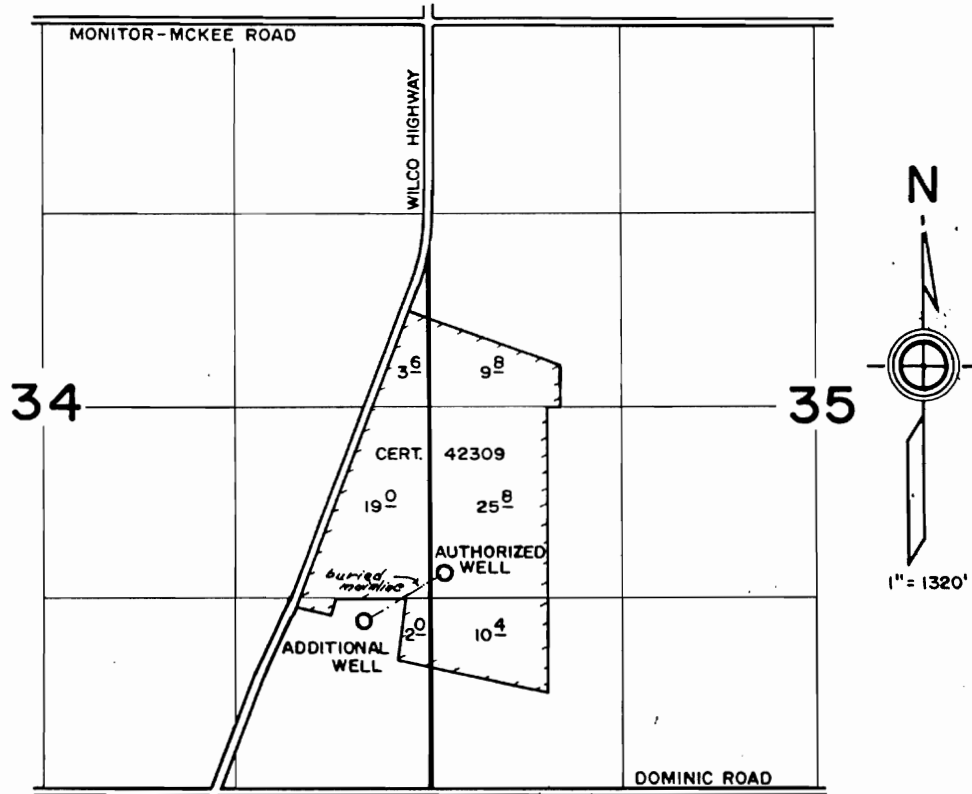

WELLS LOCATED: AUTHORIZED - 1500' N. and 130' E., ADDITIONAL - 1170' N. and 450' W.;
Both from the SW cor. Sec. 35.


FINAL PROOF SURVEY
under

Transfer 6518

in name of

JOE BOCHSLER

November 30, 1993

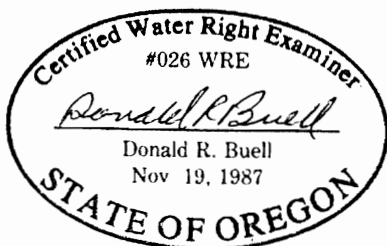

MAR 2 1994

T7111

THIS MAP WAS PREPARED FOR THE PURPOSE OF IDENTIFYING THE LOCATION OF A WATER RIGHT ONLY AND IS NOT INTENDED TO PROVIDE LEGAL DIMENSIONS OR LOCATION OF PROPERTY OWNERSHIP LINES.