



T 2 S R 38 E

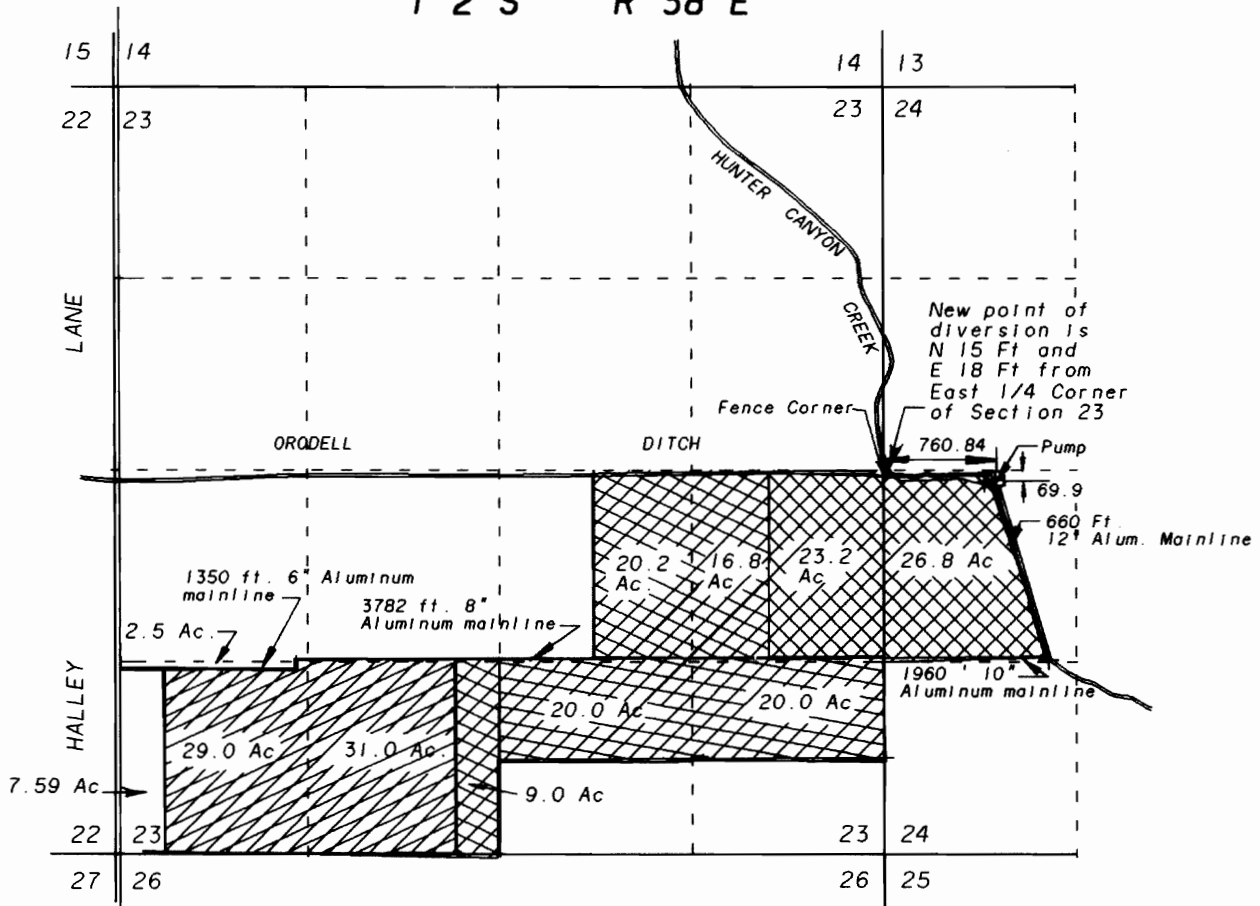


T 2 S R 38 E

1/4 corner
brass cap monument

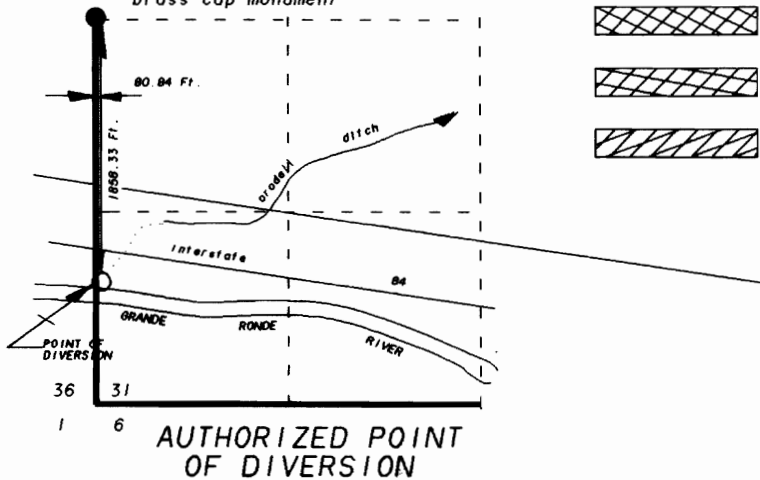

AUTHORIZED POINT
OF DIVERSION

NOTE: The preparation of this map was for the purpose of identifying the location of the proposed water right and has no intent to provide dimensions or location of property ownership lines. Location information shown hereon was furnished by the applicant.

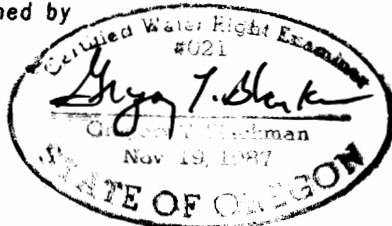

-  Transfer No. T 6523
-  Transfer No. T 6522
-  Transfer No. T 6521
-  Transfer No. T 6520

SCALE 1" = 1320'

REVISED AUGUST 29, 1994

FINAL PROOF SURVEY

FOR

Steven Lynn Stonebreaker

BY

BAGETT - GRIFFITH & ASSOCIATES
2006 ADAMS AVENUE
LAGRANDE, OREGON 97850

SEPTEMBER 23, 1993

APPLICATION NO. _____

TRANSFER NUMBERS T 6520, T 6521,

T 6522, T 6523