

SECTION LINE

25 30  
36 31

TRANSFER POINT  
OF DIVERSION

WATER LINE  
BANK LINE

IRRIGATED  
AREAS 1.1 ac.

T.L. 1106

T.L.  
1122

LEATHERS  
LANE

BIGELOW  
WAY

SCALE: 1" = 400'

1/16 LINE

2179' NORTH


1/4 LINE

1/16 LINE

R3W  
R2W

1/4 LINE

1748' WEST

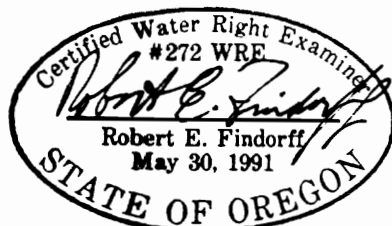

1/25/93

# FINAL PROOF MAP

PROOF OF BENEFICIAL USE

MAP FOR WATER RIGHTS

ART & BETTY BRUNI;

OWNERS

TAX LOT 20-03-36-1106

LANE COUNTY, OREGON

TRANSFER NO.: T-6560

THIS MAP IS FOR THE PURPOSE OF IDENTIFYING  
THE WATER RIGHT ONLY AND IS NOT TO  
PROVIDE LEGAL DIMENSIONS OR LOCATIONS OF  
PROPERTY OWNERSHIP LINES.

PROPERTY OWNER:  
ART & BETTY BRUNI  
34081 LEATHERS LANE  
COTTAGE GROVE, OR. 97424

NE COR. DLC 65,  
T20S, R3W, W.M.,  
LANE COUNTY BRASS  
CAP FOUND

**geomax**  
OF OREGON, INC.

ENGINEERING, LAND SURVEYING, BUILDING DESIGN  
806 N. NINTH STREET COTTAGE GROVE, OREGON 97424  
TELEPHONE-(503) 942-0126 FAX-(503) 942-7935

10/1/92