

25 30  
36 31

SECTION LINE



SCALE: 1" = 400'

WATER LINE  
BANK LINE

TRANSFER  
POINT OF  
DIVERSION

IRRIGATED  
AREAS 0.6 ac.  
(0.3 ac. ea.)

T.L.  
1106


T.L.  
1122

LEATHERS  
LANE

BIGELOW  
WAY

1/16 LINE

R3W  
R2W

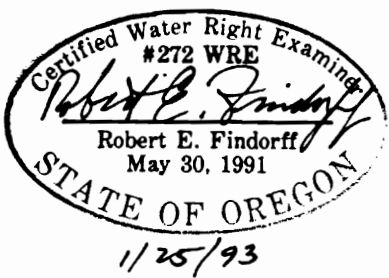

1/4 LINE

1/16 LINE

2239' NORTH

1/4 LINE

1529' WEST

**FINAL PROOF MAP**  
PROOF OF BENEFICIAL USE  
MAP FOR WATER RIGHTS  
HUGH A. & YVONNE BUERMANN;  
OWNERS  
TAX LOT 20-03-36-1122  
LANE COUNTY, OREGON

TRANSFER NO.: T-6561

PROPERTY OWNER:  
HUGH A. & YVONNE BUERMANN  
34089 LEATHERS LANE  
COTTAGE GROVE, OR. 97424

NE COR. DLC 65,  
T20S, R3W, W.M.,  
LANE COUNTY BRASS  
CAP FOUND



ENGINEERING, LAND SURVEYING, BUILDING DESIGN  
806 N. NINTH STREET COTTAGE GROVE, OREGON 97424  
TELEPHONE-(503) 942-0126 FAX-(503) 942-7935

10/1/92

THIS MAP IS FOR THE PURPOSE OF IDENTIFYING  
THE WATER RIGHT ONLY AND IS NOT TO  
PROVIDE LEGAL DIMENSIONS OR LOCATIONS OF PROPERTY  
OWNERSHIP LINES.