
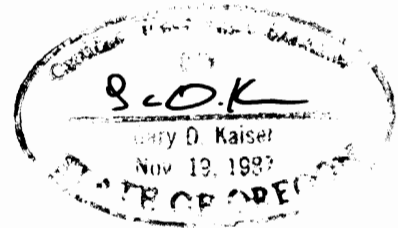


T.34S.,R.1W.,W.M.

RECEIVED

OCT 25 1998

WATER RESOURCES DEPT.  
SALEM, OREGON

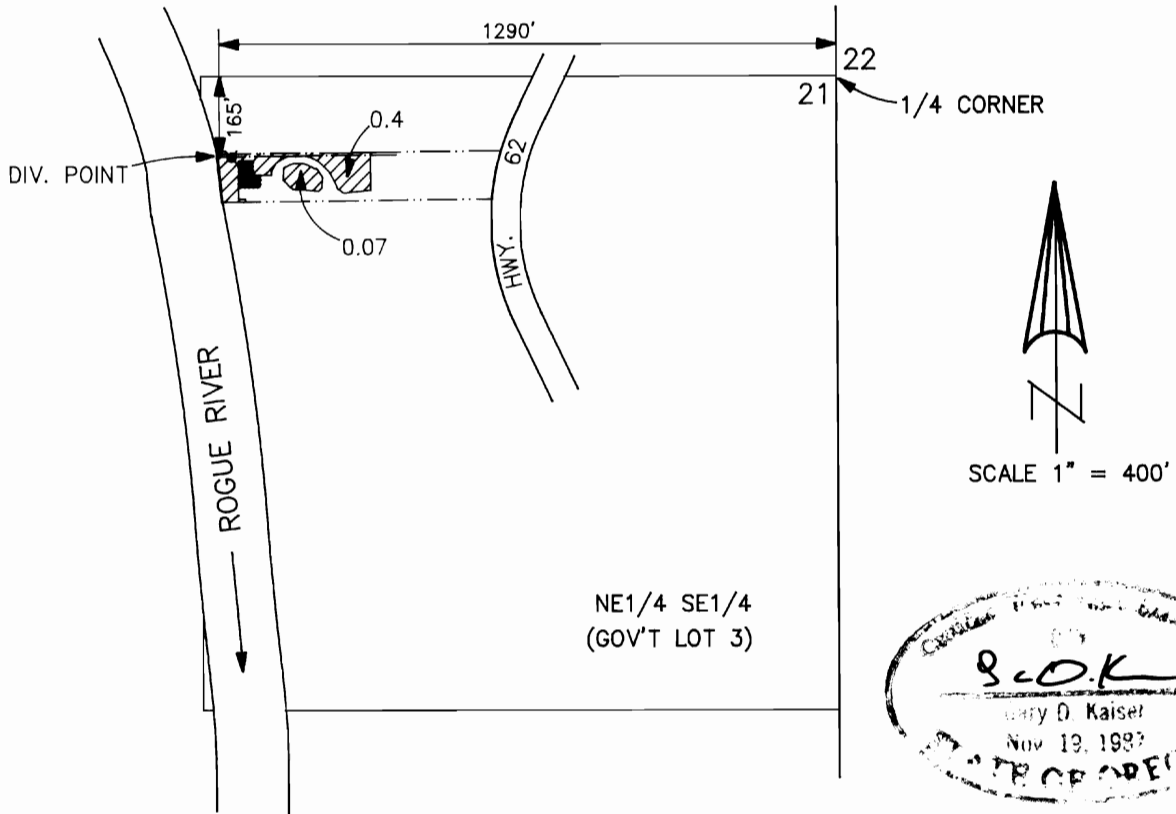

FINAL PROOF MAP  
APPLICATION No. T-6574

IN THE NAME OF  
WILLIAM L. MORSE  
AND  
YVONNE KAY MORSE

NOTE: MAP PREPARED FOR  
WATER RIGHT PURPOSES ONLY,  
NOT FOR PROPERTY BOUNDARY  
LOCATIONS.

MAP PREPARED OCTOBER 5, 1998 BY GARY D. KAISER