



Township 5 South Range 1 East, W.M.  
 Portions of Sections 25 & 26

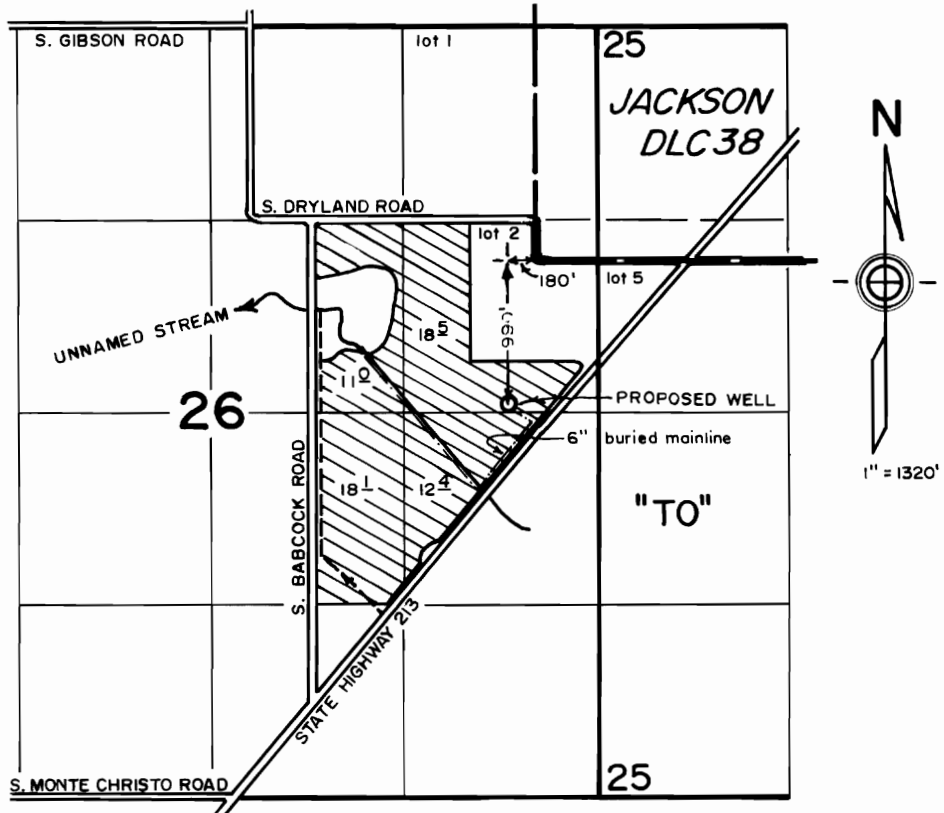

FINAL PROOF SURVEY  
 under  
 Transfer 6591  
 in name of  
 KRAEMER FARMS  
 September 21, 1993

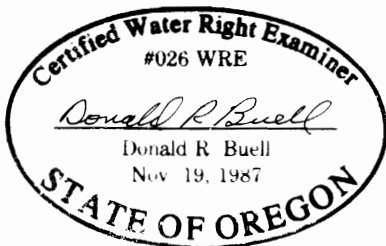

THIS MAP WAS PREPARED FOR THE PURPOSE OF IDENTIFYING THE LOCATION OF A WATER RIGHT ONLY AND IS NOT INTENDED TO PROVIDE LEGAL DIMENSIONS OR LOCATION OF PROPERTY OWNERSHIP LINES.